FORM 51 10M 7-48 PETROL


KANSAS Butler

Section 21 Township 25 Range 5E

Well No. 164 Chesney

Company Cities Service

Misc.

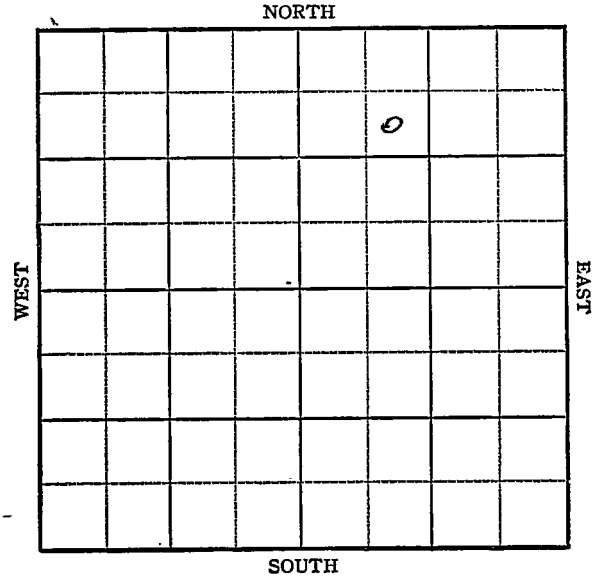

FORM 252-A
5M 10-48 PETROL

KANSAS Butler

Sec. 21 Twp. 25 R. 5E ✓

Well No. #164 Chesney Farm

Cities Service Company

Miscellaneous


990' Ft. from N. Line

_____ Ft. from S. Line

_____ Ft. from E. Line

990' Ft. from W. Line

SE NW NE

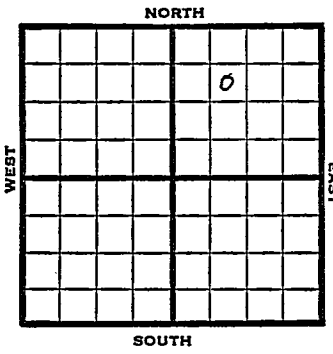

1948	Elev. 1329' REPORT
12/15	10" @ 74'
12/22	Douglas 1424' TD 1426' 7" @ 1425'
12/29	TD 1453'
1949 1/5	Douglas 1424' 7" @ 1425' Pump 15 oil & 55 W Pot. Gr. 38° TD 1453'

COMPLETED

Form 26 200 Bks. 9-48 Petrol

Kansas

Miscellaneous

Map No. _____ Sec. 21 Twp. 25 R. 5E

Well No. 164 Chesney

Cities Service Company

FIRST REPORT Contractor

SE NW NE


990 Ft. from N. Line

_____ Ft. from S. Line

_____ Ft. from E. Line

990 Ft. from W. Line

SECTION PLAT

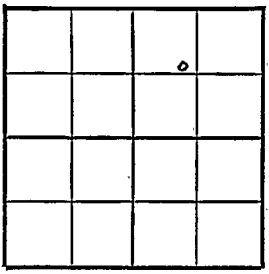

Butler County

Location _____

Rig up _____

Drilling and Remarks:

10" @ 74

RECORD

Cased _____ in., _____ ft.

Sand _____

Gas _____

Oil _____

Total Depth _____

PRODUCTION

1st 24 hrs. Nat. _____

1st 24 hrs. after shot _____

Gas _____ Cu. Ft.

Dry Hole _____

Abandoned _____

Date

DEC 15 1948 19

S. J. LEWIS Scout

Form 26 200 Bks. 9-48 Petrol

Kansas

Miscellaneous

Map No. 14 Sec. 21 Twp. 25 R. 5E

Well No. 164 Chesney


Cities Service Company

COMPLETE Contractor

SE NW NE

E 1328

SECTION PLAT

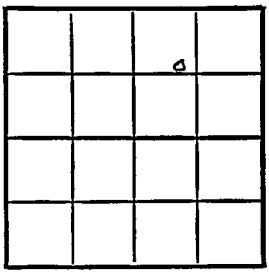

990 Ft. from N. Line

Ft. from S. Line

Ft. from E. Line

990 Ft. from W. Line

Butler County

Location

Rig up

Drilling and Remarks:

Doug Lee 1424

TD 1425

Pump Sand 455 M

P&A

38 Sx

RECORD

Cased in., ft.

Sand

Gas

Oil

Total Depth 1453

PRODUCTION

1st 24 hrs. Nat.

1st 24 hrs. after shot

Gas Cu. Ft.

Dry Hole

Abandoned

Date

JAN 5 1949 19

S. J. LEWIS Scout