


Section 21 Township 25 Range 5E

Well No. 165 Chesney

Company Cities Service

Misc.
NORTH

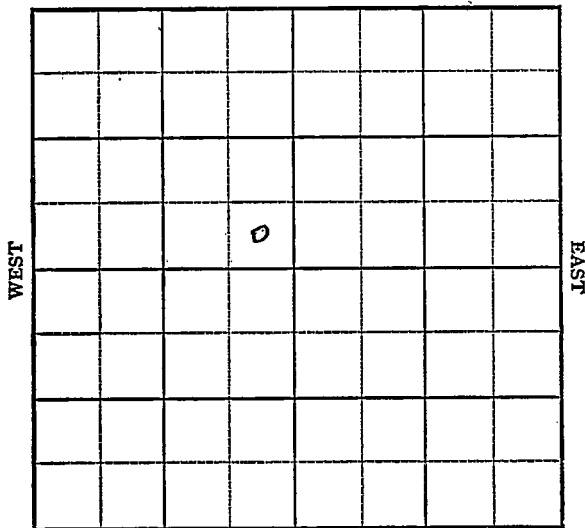

SOUTH

Sec. 21 Twp. 25 R. 5-E ✓

Well No. #165 Chesney Farm _____

Cities Service Company _____


Miscellaneous _____

_____ Ft. from N. Line

360 Ft. from S. Line

330 Ft. from E. Line

_____ Ft. from W. Line

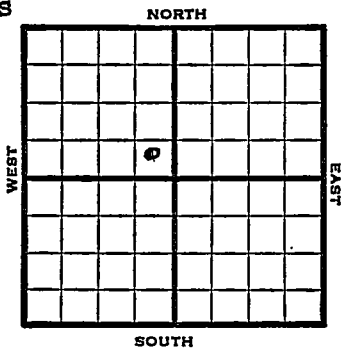

SE. NW

1948

Elev 1366' REPORT

12/22

10" @ 72'

12/29

Douglas 1456'

TD 1459'

Run csg.

1949

1/12

TD 1479'

Douglas 1456'

5" @ 1457'

Pump 53 Oil Pot

38° Gr.

Comp

COMPLETED

Map No. _____ Sec. 21 Twp. 25 R. 5E

Well No. 165 Chesney

Cities Service Company

FIRST REPORT

Contractor

SE NW

SECTION PLAT

_____ Ft. from N. Line

360 _____ Ft. from S. Line

330 _____ Ft. from E. Line

_____ Ft. from W. Line

Butler County

RECORD

Location _____

Cased _____ in. _____ ft.

Rig up _____

Sand _____

Drilling and Remarks:

Gas _____

Oil _____

Total Depth _____

10" @ 72

PRODUCTION

1st 24 hrs. Nat. _____

1st 24 hrs. after shot _____

Gas _____ Cu. Ft.

Dry Hole _____

Abandoned _____

Date

DEC 22 1948 19

S. J. LEWIS Scout

Map No. 14 Sec. 21 Twp. 25 R. 5E

Well No. 165 Chesney

Cities Service Company

COMPLETE

Contractor

SE NW

E. 1366
SECTION PLAT

 Ft. from N. Line

360 Ft. from S. Line

330 Ft. from E. Line

 Ft. from W. Line

Butler County

RECORD

Location

Cased in., ft.

Rig up

Sand

Drilling and Remarks:

Gas

Douglas 1456

5" @ 1457

Oil

Total Depth 1479

Pump 53 oil Port

PRODUCTION

1st 24 hrs. Nat.

1st 24 hrs. after shot

Gas Cu. Ft.

Dry Hole

Abandoned

35-14

Date

JAN 12 1949 19

S. J. LEWIS Scout