KANSAS


FORM 51 5M PETROL

Butler

Section 22 Township 25 Range 5-E

Well No. #18 Mills

Company Cities Service Oil

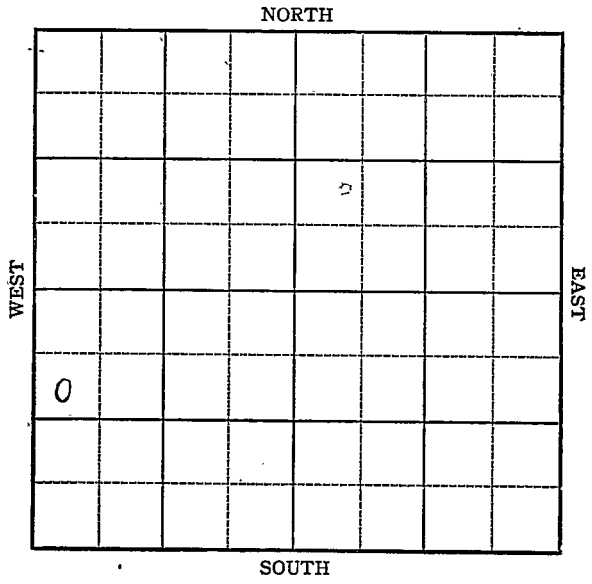

FORM 252-A
5M 9-43 GASS

KANSAS Butler

Sec. 22 Twp. 25 R. 5-E

Well No. #18 Mills Farm


Cities Service Oil Company

990 Ft. from N. Line

Ft. from S. Line

Ft. from E. Line

330 Ft. from W. Line

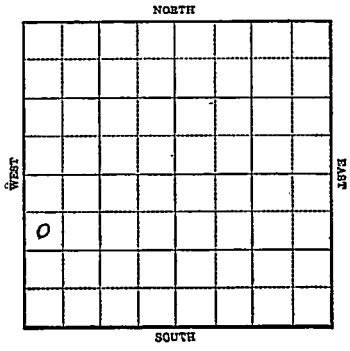

1943	REPORT
10/6	Location
10/13	"
10/20	"
10/27	"
11/3	Drlg. 250'
11/10	Lans 1637 SD T.D. 1981
11/17	BKC 2097 Marnaton 2190 TD 2198 7" @ 2190' RUST
11/24	" "
12/1	" "
12/8	" "
12-15	TD 2215' 40 Qts. at 2196' 2209 PB
12/22	PB 2029
12/29	"
1944	
1-5	190 shots 1935-2003 2000 acid
1-12	" "

OVER

1944
1/19

Lans 1637
Marmaton 2190
TD 2215
PB 2029
190 shots 1935-2003
200 acid
Pump 51 Pot.
Gravity 36

COMPLETED

Form 26 200 Bks 5-42 Petrol Butler

KANSAS Map No. 7 Sec. 22 Twp. 25 R. 5E

Well No. 18 Mills

Cities Service Oil Company

FIRST REPORT Contractor

SW NW SW


990 Ft. from N. Line

Ft. from S. Line

Ft. from E. Line

330 Ft. from W. Line

SECTION PLAT

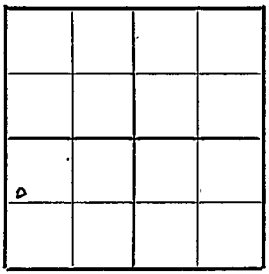

Miscellaneous

Location X

Rig up

Drilling and Remarks:

RECORD

Cased in., ft.

Sand

Gas

Oil

Total Depth

PRODUCTION

1st 24 hrs. Nat.

1st 24 hrs. after shot

Gas Cu. Ft.

Dry Hole

Abandoned

Date

OCT 6 1943 19 S. J. LEWIS Scout

Form 26 200 Bks 5-42 Petrol Butler

KANSAS 4 / Map No. Sec. 22 Twp. 25 R. 5E

Well No. 18 Mills

Cities Service Oil Company

~~COMPLETED~~ Contractor

SW NW SW


990 Ft. from N. Line

Ft. from S. Line

Ft. from E. Line

330 Ft. from W. Line

SECTION PLAT

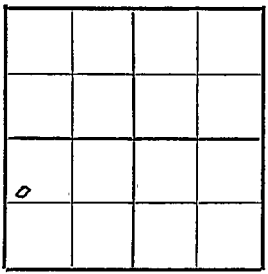

Miscellaneous

Location

Rig up

Drilling and Remarks:

Lime 1637
Marmaton 2190
PB 2029
Viola 2035-2063
2000 acid
Pump 61 BT
36° Gr

RECORD

Cased in., ft.

Sand

Gas

Oil

Total Depth 2215'

PRODUCTION

1st 24 hrs. Nat.

1st 24 hrs. after shot

Gas Cu. Ft.

Dry Hole

Abandoned

Date

JAN 19 1944 19 S. J. LEWIS Scout