

Butler


KANSAS

SECTION 22 TOWNSHIP 25 RANGE 5E

WELL NO. #1 Wilson

COMPANY R.P. Baker


NORTH ~~C NE 1/4~~ W/2 SW SE

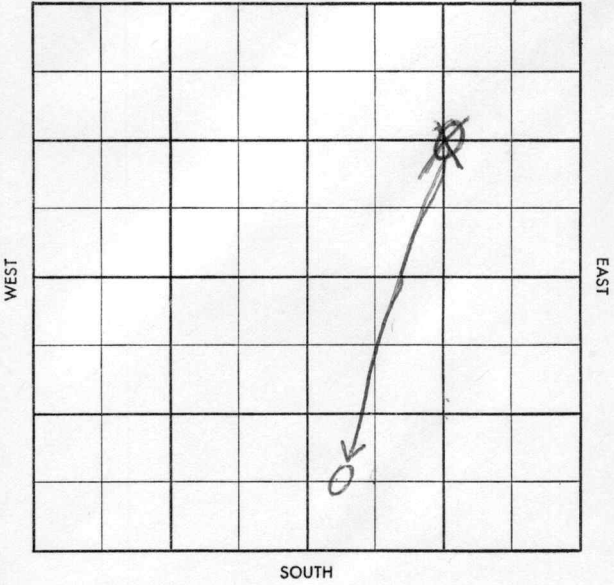

28

County Butler Elev. _____
 Sec. 22 Twp. 25 Rgs. 5E
 Company R. P. Baker
 Farm Name Wilson No. 1

TOPS	DEPTH	LOG	DATUM
Anh.			
Tr.			
H.			
Tr.			
Dg.			
B.L.			
L.			
K.C.			
B.K.C.			
Ce.			
C.			
M.			
M.			
K.			
Mz.			
Mq.			
V.			
S.			
S.			
A			
R.			
Pe.			
G.			
T.D.			

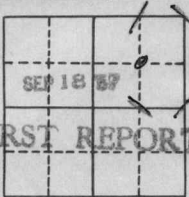Loc. in Sec. _____
C NE/4
 Geol. _____
 Contr. _____
 Co. Tools _____
 Pool _____
Eldorado

 FIRST REPORT

Date Comm. 9-2-57
10" @ 1570, Drlg. 1950 (1 BW @ 1600-1610
and 1745-1755)

Co.
 No.
 Sec.
 T.
 R.

~~29~~
CORRECTION

FORM 513 SUNRAY

County Butler Elev. 1338 D/A
 Sec. 22 Twp. 25 Rge. 5E
 Company R. P. Baker
 Farm Name Wilson No. 1

TOPS	DEPTH	LOG	DATUM	Loc. in Sec.									
Anh.				<u>C NE/4</u>									
Tr.				<u>W 1/2 SW SE</u>									
Dg.													
Bl.													
L.	<u>1695</u>			Geol.									
K.C.				Contr.									
B.K.C.				Co. Tools									
Ce.				Pool									
C.				<u>ElDorado</u>									
M.				<table border="1"> <tr> <td>OCT 16 57</td> <td></td> <td></td> </tr> <tr> <td></td> <td></td> <td></td> </tr> <tr> <td colspan="3" style="text-align: center;">ABANDONED</td> </tr> </table>	OCT 16 57						ABANDONED		
OCT 16 57													
ABANDONED													
M.													
K.													
Mz.													
Ma.													
V.	<u>2535</u>												
S.													
S.													
A.	<u>2625</u>												
R.													
Pe.													
G.													
T.D.	<u>2657</u>												

Date Comm. 9-2-57

10" @ 1570, Drlg. 1950 (1 BW @ 1600-1610 and 1745-1755)

SS 2542 5 1/2" 2602/35

10 OCT 9 57 10 2657 OCT 16 57

PB 2560 68/2530-47 230ph

+W nat 1/2 dec 1/2 Boph + 17BW

Ph 6 hrs

D/A