


Map No. _____ Sec. 26 Twp. 25 R. 5
Well No. 1 - Lichty Farm _____
L. E. Reeder Company _____

NORTH

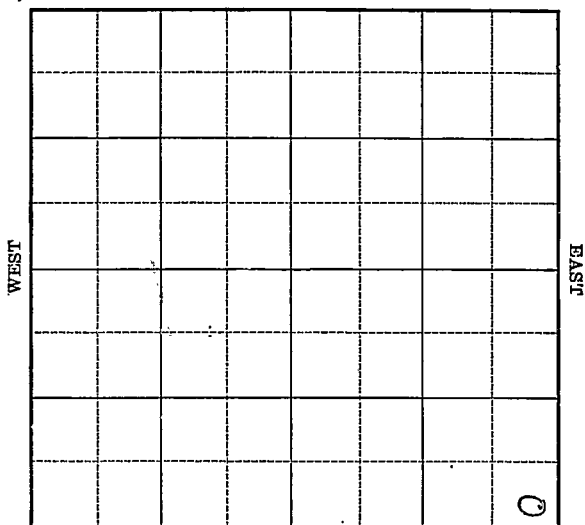

SOUTH

Location_____

Drilling Remarks

Rig Up

Drilling Remarks

RECORD

Cased_____in. _____ft.

Sand

Gas

Oil

Total Depth_____

PRODUCTION

1st 24 hrs. Nat. _____

1st 24 hrs. after shot_____

Gas _____ cu. ft.

Dry Hole_____


Abandoned _____

Map No. _____ Sec. 26 Twp. 25 R. 5Well No. 1 - Lichty Farm
J. E. Reeder Company

_____ Ft. from N. Line

200 Ft. from S. Line200 Ft. from E. Line

_____ Ft. from W. Line

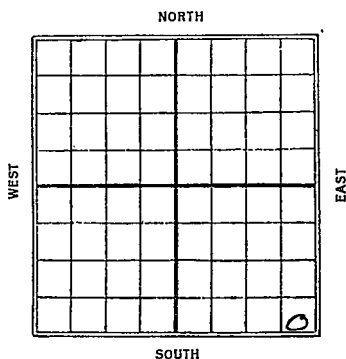1927

Date

REPORT

10/19 machine10/27 Spudding11/2 Spudding 200'11/9 Dry 425-11/16 S. W. 50011/30 abandoned 986'

Butler

14 KANSAS Map No. Sec. 26 Twp. 25 R. 5

Well No. 1 Pichy J. E. Keeder Company

Contractor

FIRST REPORTS

SECTION PLAT

			0

Ft. from N. Line

200

Ft. from S. Line

200

Ft. from E. Line

Ft. from W. Line

Location

Rig up Machine

Drilling and Remarks:

RECORD

Cased _____ in., _____ ft.

Sand _____

Gas _____

Oil _____

Total Depth _____

PRODUCTION

1st 24 hrs. Nat. _____

1st 24 hrs. after shot _____

Gas _____ Cu. Ft.

Dry Hole _____

Abandoned _____

Date

OCT 19 1927

CHAS. L. SHERWOOD

192

Scout

14 KANSAS Sec 26 Twp. 25 R. 5
 Map No. _____

Well No. 1 / Kichy
 J. E. Reeder _____ Company

 Contractor

COMPLETED

 Ft. from N. Line

200

 Ft. from S. Line

200

 Ft. from E. Line

 Ft. from W. Line

SECTION PLAT

			0

ABANDONED

Location _____

Rig up _____

Drilling and Remarks:

RECORD

Cased _____ in., _____ ft.

Sand _____

Gas _____

Oil _____

Total Depth 986

PRODUCTION

1st 24 hrs. Nat. _____

1st 24 hrs. after shot _____

Gas _____ Cu. Ft.

Dry Hole ☒

Abandoned ☒

Date

NOV 30 1927 CHAS. L. SHERWOOD

192

Scout