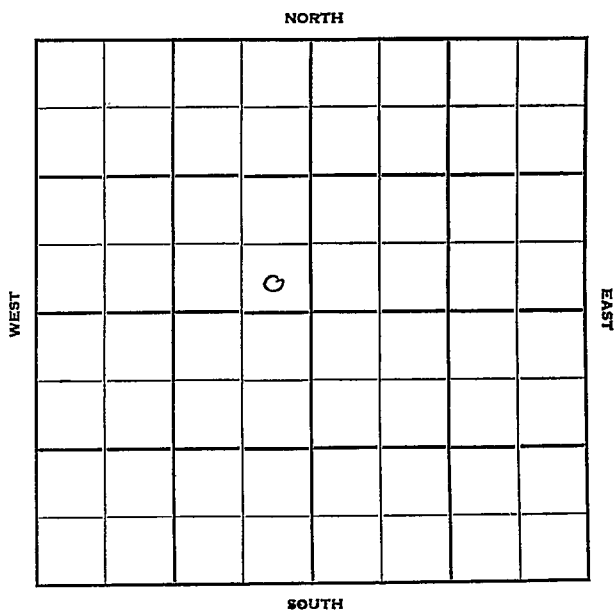


Section 13 Township 16 Range 11WWell No. #1 PichnerCompany Lewis Drlg.

Barton

KANSAS

Sec. 13 Twp. 16 R. 11 W

Well No. # 1 Pichner Farm

Lewis Drlg. Company

Lewis Contractor

Wildcat


 Ft. from N. Line

330 Ft. from S. Line

330 Ft. from E. Line

 Ft. from W. Line

SE SE NW

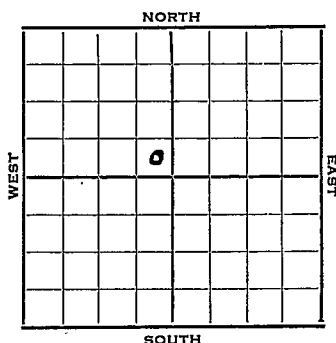

1952 Elev. 1907' REPORT

4/9 Spud 4-2-52
8" @ 221'
Anhy 795'
Drlg. 2850'


4/16 Spud 4-2-52
D & A TD 3455' 8" @ 221
Anhy 795' Heeb 2958' Br. lim 3058'
KC 3073' Cong. 3373'
DST 3373-83 open 1½ hr. rec 65' WCM
DST 3384-3400 open 1 hr. rec 6' mud
Arb. 3436'
TD 3455' D & A
ABANDONED

County Barton State Kansas
 Sec. 13 (Blk.) 16 (Sur.) 11W Map No.
 (Twp.) (Rge.)

Operator Lewis Drlg.

Well No. 1 Farm Pichner

Elev. Location SE SE NW

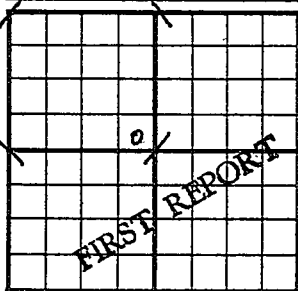

330 Ft. From S Line NW

330 Ft. From E Line Quarter

1st. Report APR 9 1952

Completion

Remarks

Lewis - Contr.

Spudding Date 4-2-52

Drlg. Data Wildcat

8" @ 221 Anhy 795 Drlg. 2850


J. G. McGEHEE

County Barton State Kansas
 Sec. 13 (Blk. Twp.) 16 (Sur. Rge.) 11W Map No.

Operator Lewis Drlg.

Well No. 1 Farm Pichner

Elev. 1907 Location SE SE NW

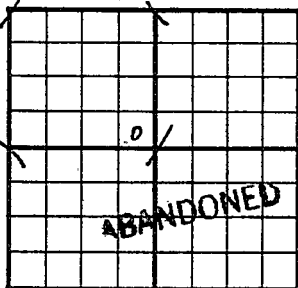

330 Ft. From S Line NW

330 Ft. From E Line Quarter

1st. Report

Completion APR 16 1952

Remarks Wilcoat

Lewis Drlg. - Contr.

Spudding Date 4-2-52

Drlg. Data D & A TD 3455

8" @ 221 Anhy 795 Heeb. 2958

Br. lime 3058 KC 3073 Cong. 3373

DST 3373-83 open 1½ hr. Rec. 65' wcm

DST 3384-3400 open 1 hr. Rec. 6' mud

Arb. 3436 TD 3455

D & A

J. G. McGEHEE