


Section 14 Township 16 Range 11W

Well No. #1 Pichner

Company D. R. Lauck

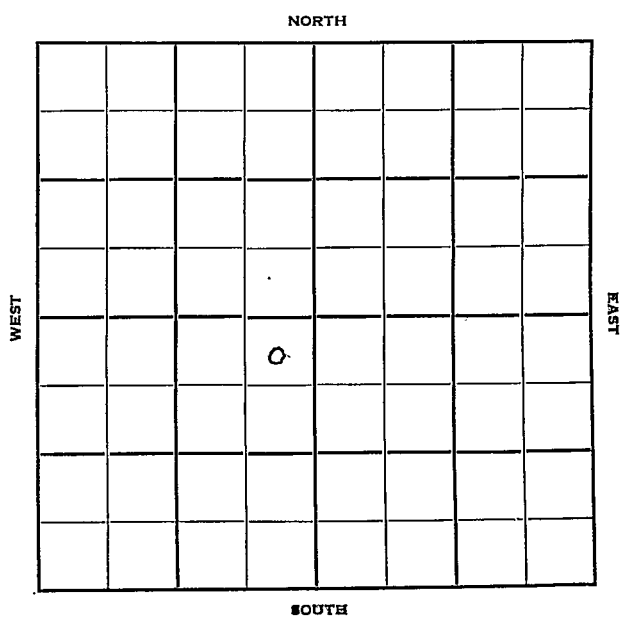

Sec. 14 Twp. KANSAS 16 R. 11-W

Well No. #1 Pichner Farm

D R Lauck Company

Contractor

Wildcat


330 Ft. from N. Line

_____ Ft. from S. Line

330 Ft. from E. Line

_____ Ft. from W. Line

NE NE SW

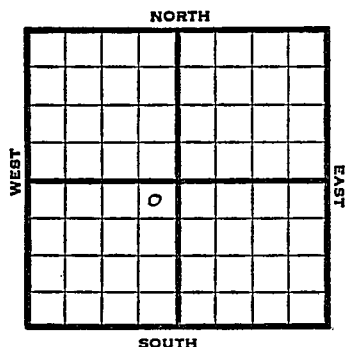

1950 Elev 1844

REPORT

7/26 Rig Up

8/16 10" @ 200

Heeb 2885

Lans 3014

DST 3224-44 opn $\frac{1}{2}$ hr rec 30' sw & mud

Cong 3310

DST 3312-28 opn 30 min rec 1100' wtr

Arb 3339-64 TD

TD 3364

D&A

ABANDONED

Map No. _____ Sec. 14 Twp. 16 R. 11WWell No. 1 PichnerD. R. Lauck

Company

Contractor

NE NE SW


SECTION PLAT

330 Ft. from N. Line

_____ Ft. from S. Line

330 Ft. from E. Line

_____ Ft. from W. Line

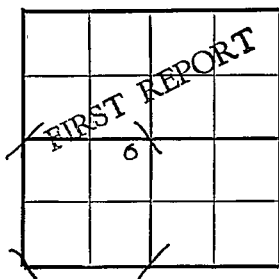

Barton County

Location _____

Rig up X

Drilling and Remarks:

RECORD

Cased _____ in., _____ ft.

Sand _____

Gas _____

Oil _____

Total Depth _____

PRODUCTION

1st 24 hrs. Nat. _____

1st 24 hrs. after shot _____

Gas _____ Cu. Ft.


Dry Hole _____

Abandoned _____

Date

JUL 26 1950 19J. E. TYRA

Scout

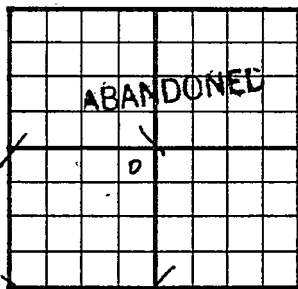County Barton State KansasSec. 14 (Blk.
Twp.) 16 (Sur.
Rge.) 11W Map No.Operator D. R. LauckWell No. 1 Farm PichnerElev. 1844 Location NE NE SW330 Ft. From N Line SW330 Ft. From E Line Quarter

1st. Report

Completion AUG 16 1950

Remarks

Spudding Date

Drilg. Data D & A TD 336410" @ 200 Heeb. 2885 Lans. 3014DST 3224-44 open $\frac{1}{2}$ hr. Rec. 30' sw & mudCong. 3310 DST 3312-28 open 30 min.Rec. 1100' water Arb. 3339-64 TDD & A

J. E. TYRA