


DX 78-1 Butler

KANSAS

Section 27 Township 25 Range 5E

Well No. #10 Draper "A"

Company Saco Oil

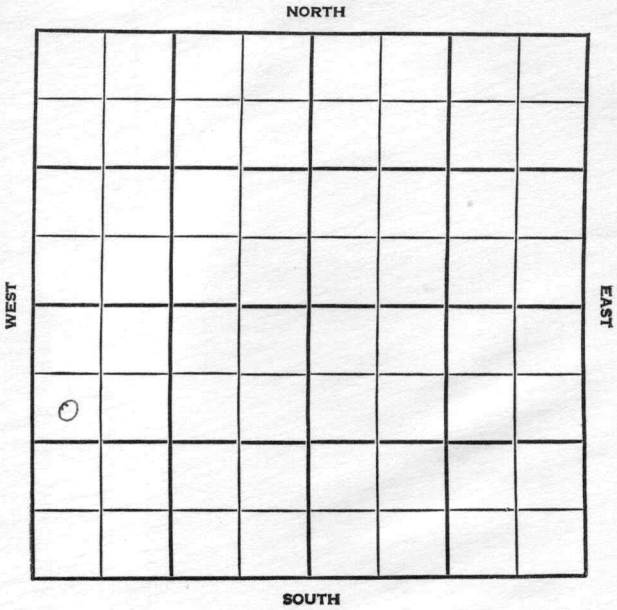

Butley

KANSAS

SEC. 27	TWP. 25	R. 5E
------------	------------	----------

WELL NO. #10 Draper "A" FARM

COMPANY Saco Oil

CONTRACTOR


**ELDorado**

\_\_\_\_\_ FT. FROM N. LINE

\_\_\_\_\_ FT. FROM S. LINE

\_\_\_\_\_ FT. FROM E. LINE

\_\_\_\_\_ FT. FROM W. LINE

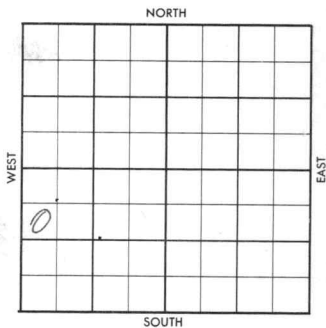

SW NW SW

1956	ELEVATION 1348'	REPORT
------	--------------------	--------

7-3 5" @ 629  
 TD 673  
 CO to 673, 25 qt.  
**POP**  
 Sd. 673'

7-11 P/ 10 BO / 100 BWPD  
 TD 673'

**COMPLETED**

29

County Butler Elev. 1348  
 Sec. 27 Twp. 25 Rge. 5E  
 Company Saco Oil  
 Farm Name Draper "A" No. 10

Co.

TOPS	DEPTH	LOG	DATUM
Anh.			
Tp.			
H.			
Tr.			
Dg.			
Bl.			
L.			
K.C.			
B.K.C.			
Ce.			
C.			
M.			
M.			
K.			
Mz.			
Me.			
V.			
S.			
S.			
A.			
R.			
PE.			
G.			
T.D.			

Loc. in Sec. SW NW SW

Geol. \_\_\_\_\_  
 Contr. \_\_\_\_\_

Pool ElDorado

FIRST REPORT  
 JUL 3 1956

Lse.

No.

Sec.

T.

R.

Date Comm. Sd. 673 5" @ 629 TD 673  
CO to 673 25 qt. POP

JUL 1 1956

58

Co.

 Sec. 27 Twp. 25 Rge. 58  
 Company Saco Oil  
 Farm Name Draper "A" No. 10

TOPS	DEPTH	LOG	DATUM	Loc. in Sec.
Anb.				SE 1/4 SW
TP.				
H.				
Tr.				
Dg.				
Bl.				
L.				Geol.
K.C.				Contr.
B.K.C.				
Ce.				Pool
C.				El Dorado
M.				
M.				
K.				
Mz.				
Mo.				
V.				
S.				
S.				
A.				
R.				
PE.				
G.				
TD.	673			

Loc.

No.

Sec.

T.

R

COMPLETE

JUL 11 1956

Date Comm.

Sd. 673 5" @ 629 TD 673

CO to 673 25 qt. POP JUL 11 '56 P.

10 B0 + 100 BWpd.