

Butler

KANSAS


FORM 51 IOM 12-46 PETROL

Section 27 Township 25 Range 5E

Well No. 6 "A" Draper

Company Saco Oil


Miscellaneous NORTH

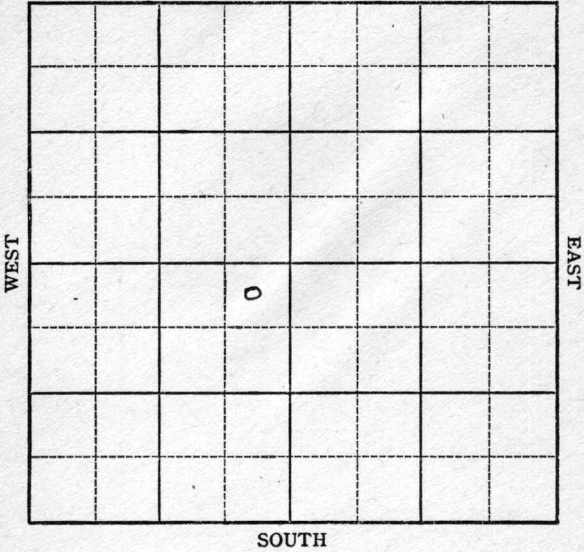

Sec. 27 Twp. 25 R. 5-E

Well No. #6 "A" Draper (twin well) Farm _____
Saco Oil Company
Miscellaneous

285 Ft. from N. Line
 _____ Ft. from S. Line
498 Ft. from E. Line
 _____ Ft. from W. Line

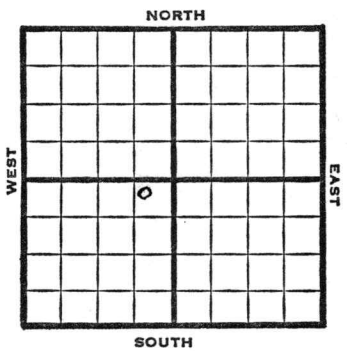

NE SW

REPORT

1947	Elev.
4/23	Machine
4/29	15" @ 80 12" @ 825 Drlg 840'
5/7	10" @ 1375' Drlg. 1750'
5/13	Drlg 2325'
5/21	Sand 2553 5" @ 2550' Pump 25 Pot TD 2555'

COMPLETED

Kansas KANSAS

Map No. 1514 Sec. 27 Twp. 25 R. 5E

Well No. 6 "A" Draper

Saco Oil Company

FIRST REPORT Contractor

NE SW

SECTION PLAT

285 Ft. from N. Line

_____ Ft. from S. Line

498 Ft. from E. Line

_____ Ft. from W. Line

	o		

Butler County

Location _____

Rig up _____

Drilling and Remarks:

Machine

twin well

RECORD

Cased _____ in., _____ ft.

Sand _____

Gas _____

Oil _____

Total Depth _____

PRODUCTION

1st 24 hrs. Nat. _____

1st 24 hrs. after shot _____

Gas _____ Cu. Ft.

Dry Hole _____

Abandoned _____

Date

APR 23 1947 19

S. J. LEWIS Scout

Map No. K 14 Sec. 27 Twp. 25 R. 5E

Well No. 6 "A" Draper

Saco Oil Company

COMPLETE

Contractor

NE SW

SECTION PLAT

	o		

285 Ft. from N. Line

_____ Ft. from S. Line

498 Ft. from E. Line

_____ Ft. from W. Line

Butler County

Location _____

Rig up _____

Drilling and Remarks:

land 2503
5' 02500
Pump 2028

85°/4

RECORD

Cased _____ in., _____ ft.

Sand _____

Gas _____

Oil _____

Total Depth 2025

PRODUCTION

1st 24 hrs. Nat. _____

1st 24 hrs. after shot _____

Gas _____ Cu. Ft.

Dry Hole _____

Abandoned _____

Date

MAY 21 1947

19

S. J. LEWIS

Scout