

27

25

5-E

Sec. _____ Twp. _____ R. _____

Well No. #8 A. Draper Farm

Saco Oil Company

Contractor

Eldorado


_____ Ft. from N. Line

150 Ft. from S. Line

_____ Ft. from E. Line

1250 Ft. from W. Line

SE SW SW

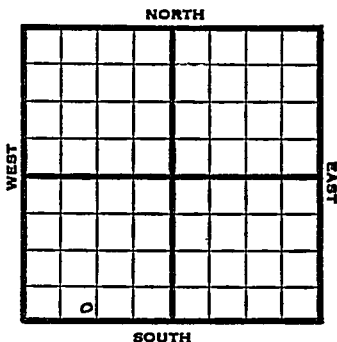

1950 Elev 1359' REPORT

12/20 Spud 12-12-50
Drlg 700'

1951
1/17 13" @ 995
Lans 1680 KC 2025
B KC 2135
8" @ 2272
Viola 2570
6" @ 2568
TD 2580 FU 800' fluid
Comp 24 gopa
Completed

COMPLFTED

