
KANSAS Barton

FORM 51 5M PETROL

Section 22 Township 17 Range 14W

Well No. 1 Eveleigh

Company Transwestern

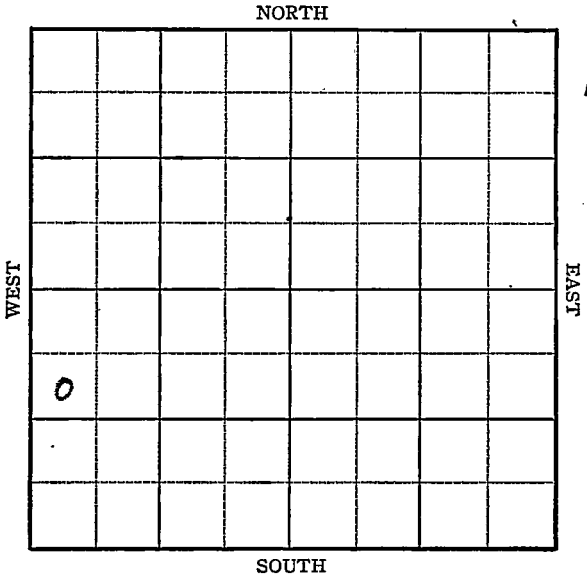

12

FORM 252-A
5M 3-45 PETROL

KANSAS Barton

Sec. 22 Twp. 17 R. 14-W

Well No. #1 Eveleigh Farm

Transwestern Company


990 Ft. from N. Line

_____ Ft. from S. Line

_____ Ft. from E. Line

330 Ft. from W. Line

SW NW SW Elev. 1867

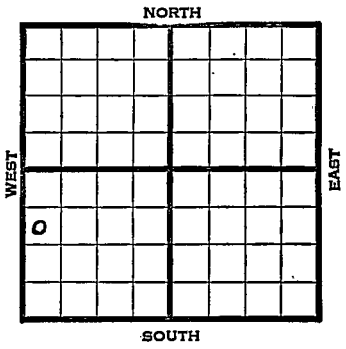

1945	REPORT
7/18	Location
7/26	Surface hole
8/1	8" @ 832 Drlg. 2170
8/8	Lans 3086 Arb. 3334 TD 3337 SSO 5" @ 3336 RUST
8/15	SLM 3337 equal 3334 Arb. 3331 TD 3336 5" @ 3333 SO
8/22	" " "
8/29	" " "
9/5	Pump 100 oil in 10 hrs. No W.
9/12	" " " " " "
9/19	Arb. 3331 5" @ 3333 2500 acid. TD 3344' Pump 336 Pot. Grav. 37.0

COMPLETED

FORM 26 200 BKS. 1-44 PETROL

KANSAS Kansas Pool Name Carroll

Map No. 73 Sec. 22 Twp. 17 R. 14W

Well No. 1 Eveleigh

Transwestern Company

FIRST REPORT

Contractor

SW NW SW

990 Ft. from N. Line


Ft. from S. Line

Ft. from E. Line

330 Ft. from W. Line

Barton County

SECTION PLAT

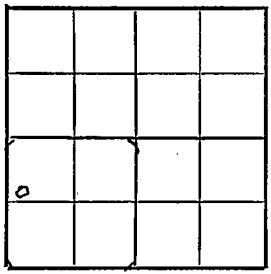

Location x

Rig up

Drilling and Remarks:

RECORD

Cased in., ft.

Sand

Gas

Oil

Total Depth

PRODUCTION

1st 24 hrs. Nat.

1st 24 hrs. after shot.

Gas Cu. Ft.

Dry Hole

Abandoned

Date

JUL 1 8 1945 19 S. J. LEWIS Scout

FORM 26 200 BKS. 1 44 PETROL

KANSAS

Kansas

Pool Name Carroll

Map No. 73 Sec. 22 Twp. 17 R. 14W

Well No. 1 Eveleigh


Transwestern Company

COMPLETED Contractor

SW NW SW

E. 1867

SECTION PLAT

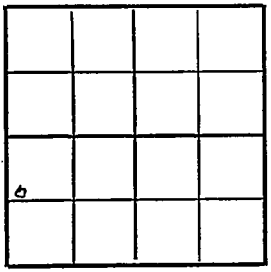

990 Ft. from N. Line

Ft. from S. Line

Ft. from E. Line

330 Ft. from W. Line

Barton County

Location

Rig up

Drilling and Remarks:

Cer 3331

5" @ 3333

250 acid

Pump 336 Pd

37° Gr

RECORD

Cased in., ft.

Sand

Gas

Oil

Total Depth 3344

PRODUCTION

1st 24 hrs. Nat.

1st 24 hrs. after shot

Gas Cu. Ft.

Dry Hole

Abandoned

Date

SEP 1 9 1945 19

S. J. LEWIS Scout