


Section 17 Township 25 Range 5-E

Well No. #2 Robinson

Company Wilson oil

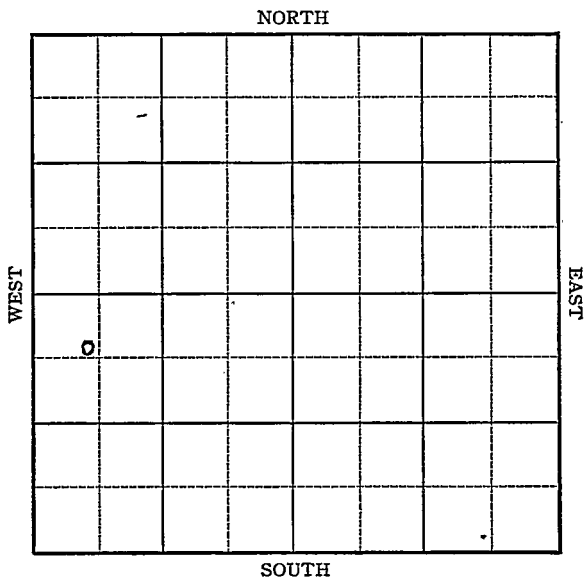

KANSAS

Butler

Sec. 17 Twp. 25 R. 5-E

Well No. #2 Robinson Farm

Wilson Oil Company

Miscellaneous


495 Ft. from N. Line

_____ Ft. from S. Line

_____ Ft. from E. Line

495 Ft. from W. Line

h. No. 1392

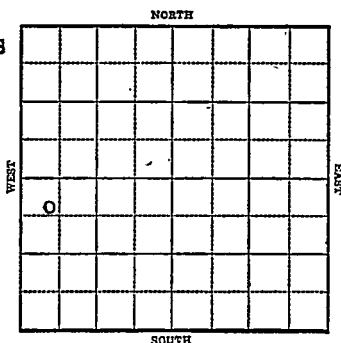

1943

R E P O R T

- 6/9 Cable rig
- 6/16 " "
- 6/23 Drlg. 240'
- 6/30 Drlg. 910
12" @ 840'
- 7/7 10" @ 1700'
Drlg. 1820'
- 7/15 KC 1950
8" @ 2160'
Drlg. 2350'
- 7/21 Chat 2540'
T.D. 2557
7" @ 2540C0
- 7/28 Chat. 2540
7" @ 2540
T.D. 2557'
Pump 40 Pot
Gravity 36.4

COMPLETED

Butler

KANSAS

Map No. 4 Sec. 17 Twp. 25 R. 5E

Well No. 2 Robinson

Wilson Oil Company

FIRST REPORT Contractor

C NW SW

SECTION PLAT

495 Ft. from N. Line

_____ Ft. from S. Line

_____ Ft. from E. Line

495 Ft. from W. Line

o			

MISCELLANEOUS

Location _____

Rig up _____

Drilling and Remarks:

Gable

RECORD

Cased _____ in., _____ ft.

Sand _____

Gas _____

Oil _____

Total Depth _____

PRODUCTION

1st 24 hrs. Nat. _____

1st 24 hrs. after shot _____

Gas _____ Cu. Ft.

Dry Hole _____

Abandoned _____

Date

JUN 9 1943 19

S. J. LEWIS Scout

KANSAS

Map No. 14 Sec. 17 Twp. 25 R. 5E

Well No. 2 Robinson

Wilson Oil Company

COMPLETED Contractor

C NW SW

495 Ft. from N. Line

_____ Ft. from S. Line

_____ Ft. from E. Line

495 Ft. from W. Line

SECTION PLAT

o			

MISCELLANEOUS

Location _____

Rig up _____

Drilling and Remarks:

*Cha 2540
7" @ 2540
Pump 40 P.S.*

36 1/2

RECORD

Cased _____ in., _____ ft.

Sand _____

Gas _____

Oil _____

Total Depth 2537

PRODUCTION

1st 24 hrs. Nat. _____

1st 24 hrs. after shot _____

Gas _____ Cu. Ft.

Dry Hole _____

Abandoned _____

Date

JUL 28 1943 19

S. J. LEWIS Scout