


KANSAS

Barton county

Section 22 Township 17 Range 11W

Well No. #3, Eveleigh

Company Anderson & Prichard

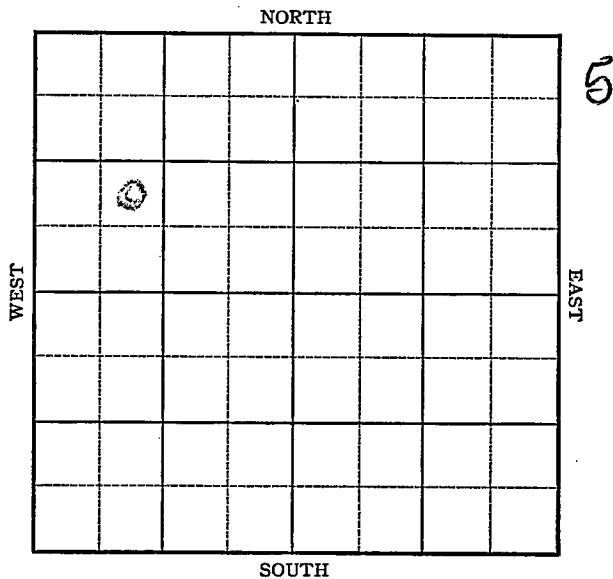

KANSAS

Barton County ✓

Sec. 22 Twp. 17 R. 14WWell No. #3 Eveleigh FarmAnderson & Prichard Company

Carroll

Ft. from N. Line

990


Ft. from S. Line

Ft. from E. Line

990

Ft. from W. Line

NE SW NW

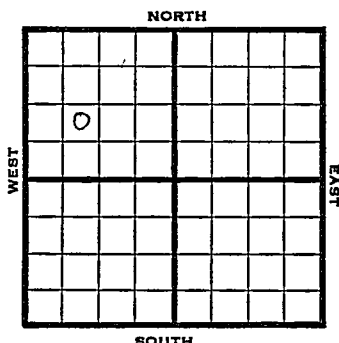

1946

Elev 1878' REPORT

5/1

Anhy. 826
Drlg. 840'

5/7

8" @ 905
Drlg 2155'

5/14

Lans 3102
Arb 3361-62
TD 5" @ 3362 R^UST

5/21

TD 3368 $\frac{1}{2}$ -500 acid
Swb 3 oil PH SW

5/29

" " "

6/5

Pump 100 oil 12 hrs.

6/12

Arb 3361'
5" @ 3362
Pump 182 Pot
39.7 Gr
TD 3368 $\frac{1}{2}$

COMPLETED

KANSASKansas Pool Name CarrollMap No. 73 Sec. 22 Twp. 17 R. 14WWell No. 3 EveleighAnderson & Prichard Company**FIRST REPORT**

Contractor

NE SW NW

SECTION PLAT

o			

 Ft. from N. Line990 Ft. from S. Line Ft. from E. Line990 Ft. from W. LineBarton CountyLocation Rig up

Drilling and Remarks:

Anhy 826

d rlg. 840

RECORDCased in., ft.Sand Gas Oil Total Depth **PRODUCTION**1st 24 hrs. Nat. 1st 24 hrs. after shot Gas Cu. Ft.Dry Hole Abandoned

Date

MAY 1 1946

19

S. J. LEWIS

Scout

KANSAS Pool Name Carroll PoolMap No. 73 Sec. 22 Twp. 17 R. 14WWell No. 3 EveleighAnderson & Prichard Company**COMPLETED**

Contractor

NE SW NW

E 1/1878
SECTION PLAT

o			

 Ft. from N. Line990 Ft. from S. Line Ft. from E. Line990 Ft. from W. LineBarton CountyLocation Rig up

Drilling and Remarks:

Cor 433615" @ 3362Pump 182 Pst39 7/8**RECORD**Cased in., ft.Sand Gas Oil Total Depth 3368 1/2**PRODUCTION**1st 24 hrs. Nat. 1st 24 hrs. after shot Gas Cu. Ft.Dry Hole Abandoned

Date

JUN 1 2 1946

19

S. J. LEWIS

Scout