Barton


FORM 51 10M 8-47

KANSAS

Section 22 Township 17 Range 14 W

Well No. #4 Eveleigh

Company Sunray

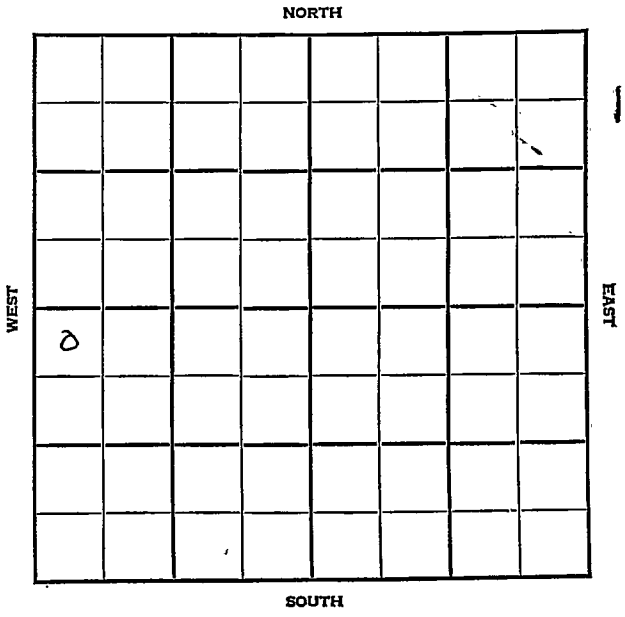

FORM 252-A
5M 4-48 PETROL

KANSAS Barton

Sec. 22 Twp. 17 R. 14W

Well No. #4 Eveleigh Farm

Sunray Company

Carroll Pool


330' Ft. from N. Line

Ft. from S. Line

330' Ft. from E. Line

Ft. from W. Line

NW SW

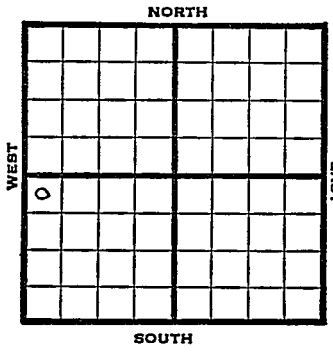

1948	REPORT
	Eli 1866'
6/30	8" @ 820' WOC
7/8	Lansing 3082' Arbuckle 3323-27' TD 3327' 5"@ 3325'
7/14	TD 3335' 500 acid Swb 4 bbls oil PH
7/21	"
7/28	Arb. 3323' 5"@ 3325' TD 3335' 500 acid Pump 118 Oil Pot 37⁴ Gr. Comp. COMPLETED

Form 26—200 Bks.—1-48—Palace

Carroll Pool

Kansas

Map No. _____ Sec. 22 Twp. 17 R. 14W


Well No. 4 Eveleigh

Sunray Company

FIRST REPORT Contractor

NW SW

SECTION PLAT

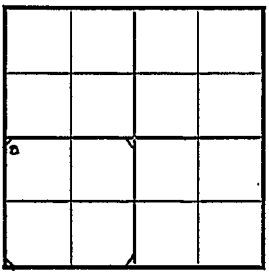

330 Ft. from N. Line

_____ Ft. from S. Line

_____ Ft. from E. Line

330 Ft. from W. Line

Barton County

Location _____

Rig up _____

Drilling and Remarks:

8" @ 820 WOC

RECORD

Cased _____ in., _____ ft.

Sand _____

Gas _____

Oil _____

Total Depth _____

PRODUCTION

1st 24 hrs. Nat. _____

1st 24 hrs. after shot _____

Gas _____ Cu. Ft.

Dry Hole _____

Abandoned _____

Date

JUN 30 1948 19 S. J. LEWIS Scout

Form 27—100 Bks.—4-48—Petrol

Barton County Kansas State

Map No. 73 Sec. 22 Twp. 17 R. 14W

Well No. 4 Eveleigh


Sunray Company

COMPLETE Contractor

E.1826

NW SW

SECTION PLAT

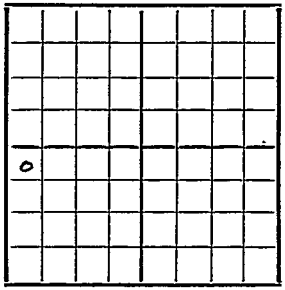

330 Ft. from N. Line

Ft. from S. Line

Ft. from E. Line

330 Ft. from W. Line

Carroll Pool

Remarks:

Csg 8 3/4" @ 325'

5 1/2" @ 3325'

T.D. 3325'

500 Rock

Pump 118 bbls Oil

39 Hrs

Date JUL 28 1948

Scout S. J. LEWIS