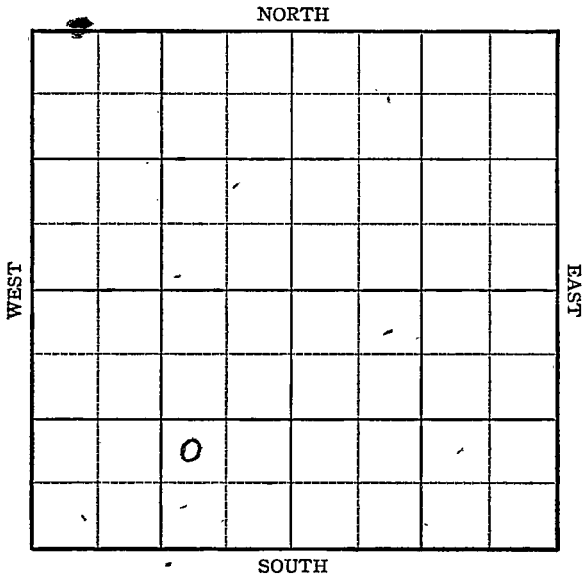


KANSAS

Barton

FORM 51 5M PETROL

Section 16 Township 16 Range 11WWell No. #1 LaudickCompany Harbar & Sinclair Prairie

KANSAS

Barton

Sec. 16 Twp. 16 R. 11-W

Well No. #1 Laudick Farm

Harbar & Sinclair Prairie Company


Kraft-Prusa

Ft. from N. Line

990 Ft. from S. Line

990 Ft. from E. Line

Ft. from W. Line

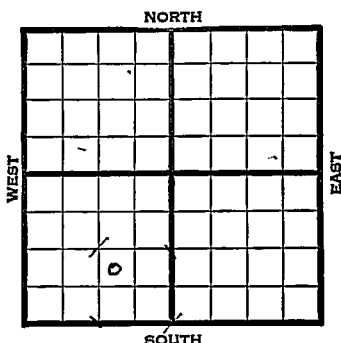

NW SE SW Elev. 1852

1945

REPORT

7/3 Location

7/11 Spud

7/19 10" @ 354

Anhy 700

Drilg. 2045

7/26 Lans 2980

Drilg. 3080

8/1 Lans 3015 corrected

Arb. 3356-3352

TD 3352'

5" @ 3237 RUST

8/8 PB 3213

30 shots 3180-3188 4000 acid. CO

8/15 430' Wtr. in 12 hrs.

8/22 Arb. 3346

5" @ 3237

Lans 2980

Perf. Lans. 4000 acid, wtr.

TD 3352

ABANDONED

KANSAS

Kansas

Pool Name Kraft-PrusaMap No. 55 Sec. 16 Twp. 16 R. 11WWell No. 1 LaudickHarbar & Sinclair Prairie Company

FIRST REPORT

Contractor

NW SE SW

SECTION PLAT

Ft. from N. Line990 Ft. from S. Line990 Ft. from E. LineFt. from W. LineBarton CountyLocation X

Rig up

Drilling and Remarks:

RECORD

Cased in., ft.Sand Gas Oil Total Depth

PRODUCTION

1st 24 hrs. Nat. 1st 24 hrs. after shot Gas Cu. Ft.Dry Hole Abandoned

Date

JUL 3 1945 19 S. J. LEWIS Scout

KANSASPool Name Kraft-PrusaMap No. 55 Sec. 16 Twp. 16 R. 11WWell No. 1 LaudickHarbar & Sinclair Prairie Company**ABANDONED**

Contractor

NW SE SW

E 1/8 32
SECTION PLAT

Ft. from N. Line

990

Ft. from S. Line

990

Ft. from E. Line

Ft. from W. Line

Barton County

Location

Rig up

Drilling and Remarks:

Ar 833465" @ 9237Lane 2980Perf Lane4000 acid water**RECORD**

Cased _____ in.; _____ ft.

Sand _____

Gas _____

Oil _____

Total Depth 3352**PRODUCTION**

1st 24 hrs. Nat. _____

1st 24 hrs. after shot _____

Gas _____ Cu. Ft.

Dry Hole _____

Abandoned _____

Date

AUG 22 1945

19

S. J. LEWIS

Scout