Barton

FORM 51 5M 6-46 PETROL


KANSAS

Section 22 Township 17 Range 14W

Well No. 3 Eveleigh

Company Sunray

Eveleigh

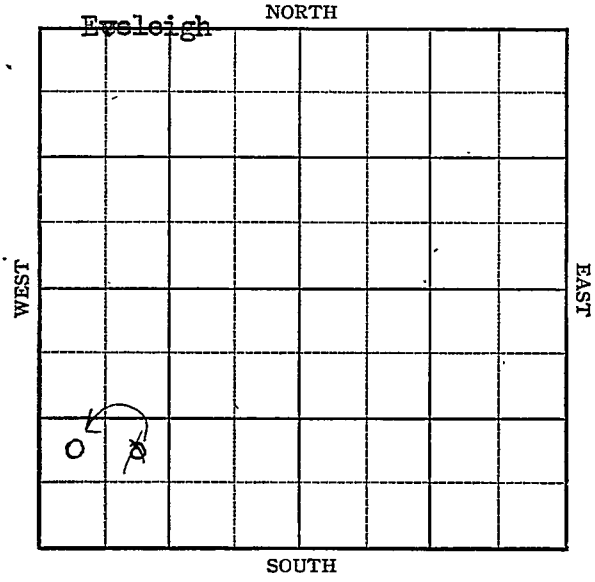

FORM 252-A
5M 12-46 PETROL

KANSAS Barton County

Sec. 22 Twp. 17 R. 14W

Well No. 3 Eveleigh Farm

Sunray Company

Eveleigh Pool


____ Ft. from N. Line

990 Ft. from S. Line

____ Ft. from E. Line

~~990~~ 330 Ft. from W. Line

NW NE SW SW

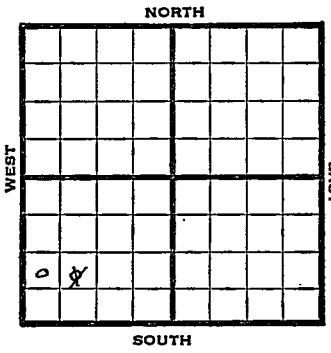

1947	Elev. 1859' REPORT
5/7	Anhy 816' 8" @ 826 WOC
5/13	Drlg. 2800'
5/20	Lans 3076 Cong 3321 Arb 3338-45 TD 3345 5" @ 3340 RUST
5/27	500 Acid.
6/4	Arb. 3337' 5" @ 3340' 500 Acid Pump 133 Pot 37.0 Gr. TD 3345'

COMPLETED

Form 26 200 Bks. 10-46 Petrol

Kansas

Eveleigh Pool

Map No. K 73 Sec. 22 Twp. 17 R. 14W


Well No. 3 Eveleigh

Sunray Company

FIRST REPORT Contractor

NE SW SW

SECTION PLAT

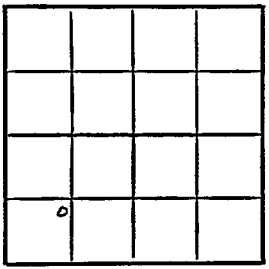

____ Ft. from N. Line

990 Ft. from S. Line

____ Ft. from E. Line

990 Ft. from W. Line

Barton County

Location

Rig up

Drilling and Remarks:

Anhy 816

8" @ 826 WOC

RECORD

Cased ____ in., ____ ft.

Sand

Gas

Oil

Total Depth

PRODUCTION

1st 24 hrs. Nat.

1st 24 hrs. after shot

Gas ____ Cu. Ft.

Dry Hole

Abandoned

Date

MAY 7 1947

19

S. J. LEWIS Scout

Form 26 200 Bks. 10-46 Petrol
Kansas

Eveleigh Pool

Map No. K73 Sec. 22 Twp. 17 R. 14W

Well No. 3 Eveleigh


Sunray Company

CORRECTION

Contractor

NW SW SW

SECTION PLAT

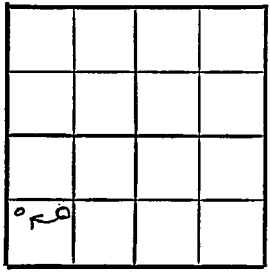

____ Ft. from N. Line

990 Ft. from S. Line

____ Ft. from E. Line

330 Ft. from W. Line

Barton County

Location

Rig up

Drilling and Remarks:

Reported

NE SW SW

RECORD

Cased ____ in., ____ ft.

Sand

Gas

Oil

Total Depth

PRODUCTION

1st 24 hrs. Nat.

1st 24 hrs. after shot

Gas ____ Cu. Ft.

Dry Hole

Abandoned

Date

MAY 21 1947

19 S. J. LEWIS Scout

Form 26 200 Bks. 10-46 Petrol
Kansas

Eveleigh Pool

Map No. 73 Sec. 22 Twp. 17 R. 14W


Well No. 3 Eveleigh

Sunray Company

COMPLETE Contractor

NW SW SW

E. 1859
SECTION PLAT

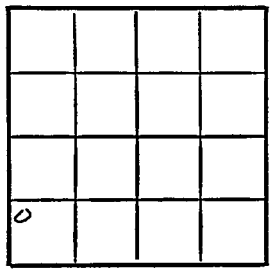

Ft. from N. Line

990 Ft. from S. Line

Ft. from E. Line

330 Ft. from W. Line

Barton County

Location

Rig up

Drilling and Remarks:

Ran 3337
5" @ 3340
Tobacco
Pump 183 BF
87 Gr

RECORD

Cased in., ft.

Sand

Gas

Oil

Total Depth 3345

PRODUCTION

1st 24 hrs. Nat.

1st 24 hrs. after shot

Gas Cu. Ft.

Dry Hole

Abandoned

Date

JUN 4 1947 19 S. J. LEWIS Scout