

Cowley

**KANSAS**

SECTION 7 TOWNSHIP 32S RANGE 8E

WELL NO. #3 Jarvis "D"


COMPANY McNeish & Gralapp

NORTH

NW/C Lot 6

WEST

EAST

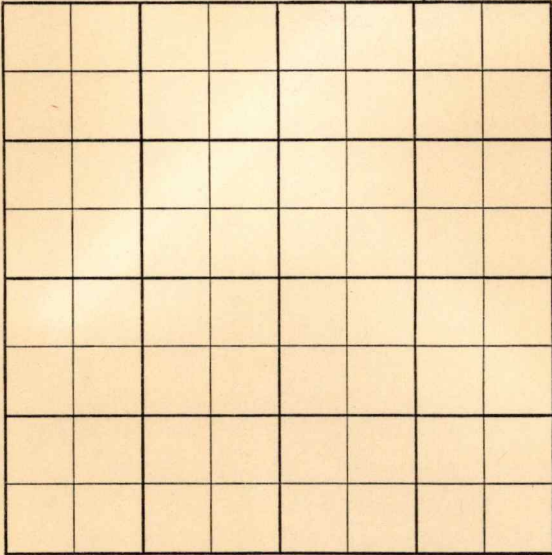

SOUTH

30

County Cowley Elev. \_\_\_\_\_  
 Sec. 7 Twp. 32 Rge. 8E  
 Company McNeish & Galapp  
 Farm Name Jarvis "D" No. 3

TOPS	DEPTH	LOG	DATUM
Anh.			
Tp.			
H.			
Tr.			
Dg.			
B.L.			
L.			
K.C.			
B.K.C.			
Ce.			
C.			
M.			
M.			
K.			
Mz.			
Mq.			
V.			
S.			
S.			
A.			
R.			
Pf.			
G.			
T.D.			

Loc. in Sec. \_\_\_\_\_  
NW/C Lot 6  
 Geol. \_\_\_\_\_  
 Contr. \_\_\_\_\_  
Watson Drlg.  
 Pool \_\_\_\_\_  
Windsor SW

**FIRST REPORT**  
 JAN 29 58

Date Comm. \_\_\_\_\_ (Skelly Oil - FO)

8" @ 200 - WORT

---



---



---



---



---



---



---



---



---



---

Co.  
No.  
Sec.  
T.  
R.

County Cowley Elev. 1294 KB  
 Sec. 7 Twp. 32 Rge. 8E  
 Company McNeish & Galapp  
 Farm Name Jarvis "D" No. 3

TOPS	DEPTH	LOG	DATUM
Anh.			
Tp.			
H.			
Tr.			
Dg.			
B.L. <u>10tan</u>	<u>1466</u>		
L. <u>stal</u>	<u>1538</u>		
K.C.L. <u>stal</u>	<u>1658</u>		
B.K.C. <u>Hog</u>	<u>1882</u>		
Ce. <u>Lay</u>	<u>1924</u>		
C.			
M.			
M.			
K.			
Mz.			
Mq.			
V.			
S.			
S.			
A.			
R.			
Pf.			
G.			
T.D.	<u>2017</u>		

Loc. in Sec. NW/C Lot 6

Geol. \_\_\_\_\_  
 Contr. \_\_\_\_\_  
Watson Drlg.

Pool \_\_\_\_\_  
Windsor SW

**ABANDONED**

MAR 5 1958

Date Comm. 2-1-58 (Skelly Oil - FO)  
8" @ 200 - WORT 15 5 58 1600 FEB 12 58  
end 1926-52 5" 1977 CO 15/  
1948-53 FU 150' W 50 12hrs  
 FEB 19 58 PB 112/1536-64  
 MAR 5 58

SWDW Nat