


Barton

KANSAS

SECTION 15 TOWNSHIP 16 RANGE 11W

WELL NO. #3 Redetzek

COMPANY Wilkinson Drlg.

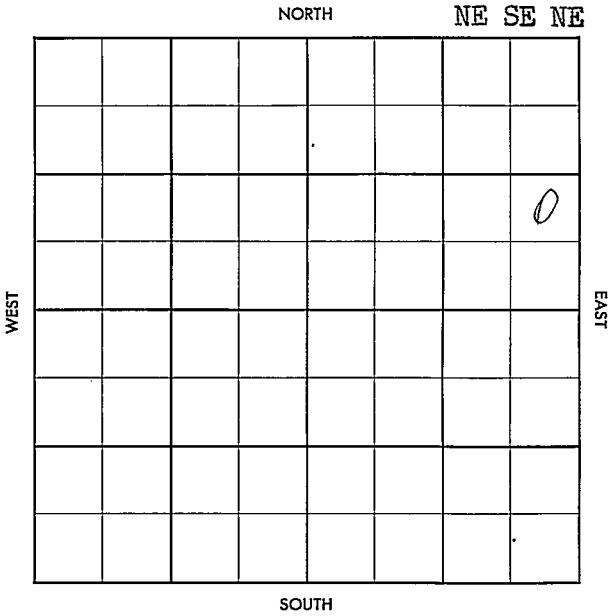

County Barton Elev. _____
 Sec. 15 Twp. 16 Rgs. 11W
 Company Wilkinson Drlg.
 Farm Name Redetek No. 3

TOPS	DEPTH	LOG	DATUM	Loc. in Sec.																														
Anb.	700			NE SE NE																														
TP.																																		
H.																																		
Tr.																																		
Dg.																																		
Bl.																																		
L.				Geol. _____																														
K.C.				Contr. _____																														
B.K.C.				Co. tools _____																														
Ce.				Pool _____																														
C.				Fsfield																														
M.				<table border="1"> <tr><td></td><td></td><td></td></tr> <tr><td></td><td></td><td></td></tr> <tr><td></td><td></td><td></td></tr> <tr><td></td><td></td><td></td></tr> <tr><td></td><td></td><td></td></tr> <tr><td></td><td></td><td></td></tr> <tr><td></td><td></td><td></td></tr> <tr><td></td><td></td><td></td></tr> <tr><td></td><td></td><td></td></tr> <tr><td></td><td></td><td></td></tr> </table>																														
M.																																		
K.																																		
Mz.																																		
Me.																																		
V.																																		
S.																																		
S.																																		
A.																																		
R.																																		
PE.																																		
G.																																		
T.D.																																		

FIRST REPORT
MAY 22 '57

Date Comm. 5-18-57
82 @ 398/225 drlg. 1890

~~13~~

Co.
Lse.
No.
Sec.
T.
R.

County Barton Elev. 1862
 Sec. 15 Twp. 16 Rgs. 11W
 Company Wilkinson Drlg.
 Farm Name Reznek No. 3

TOPS:	DEPTH	LOG	DATUM	Loc. in Sec.
Anb.	7000			NE SE NE
Tr.				
H.	2893			
Tr.				
Dg.				
BL.	2989			
L.	3003			Geol.
K.C.				Contr.
B.K.C.				Co. tools
Ce.				Pool
C.	3303			Esfeld
M.				
M.				
K.				
Mz.				
Mo.				
V.				
S.				
S.				
A.	3356			
R.				
PE.				
G.				
TD.	3365			ABANDONED

JUN 12 57
 O
 ABANDONED

Date Comm. 5-18-57
82 @ 398/225 drlg. 1890 MAY 29 57
LN 3 57

DEA (~~###~~)