

BARTON

KANSAS

15

16S


11W

SECTION _____ TOWNSHIP _____ RANGE _____

WELL NO. #1 Hedetzke "C"

COMPANY Grant Oil Co.

NORTH

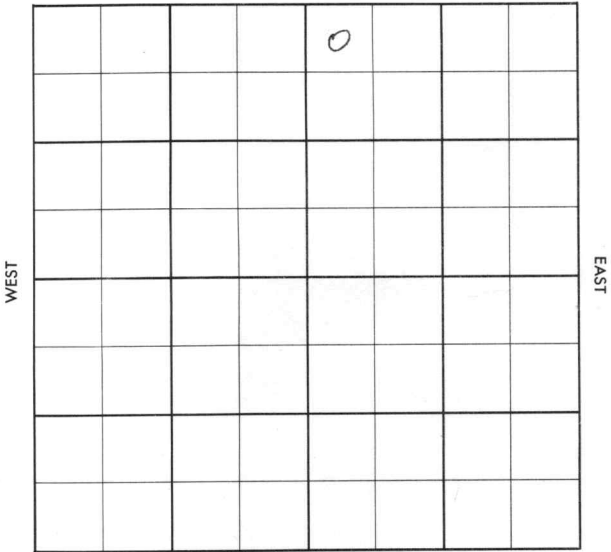

SOUTH

SEC. 15	TWP. 16S	R. 11W
------------	-------------	-----------

WELL NO.

1 Redetzke "C"

FARM

COMPANY

Grant Oil Co.

CONTRACTOR

Walters


Esfeld

_____ FT. FROM N. LINE

_____ FT. FROM S. LINE

_____ FT. FROM E. LINE

_____ FT. FROM W. LINE

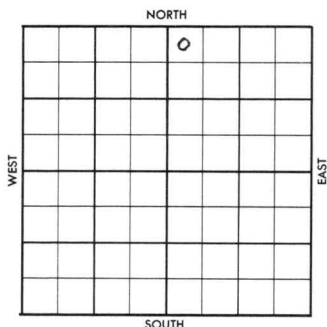NW NW NE DS - NE $\frac{1}{4}$ 

	ELEVATION	REPORT
1956	1883'	

6-20

MIRT

7-25

Spud 6-18-56

8 5/8" @ 188

DST 3348-69 op 1 hr, rec. 120' ocm &
w / 60' ocm / 80' oil / 40' wtr. ~~END~~
870/20"

5 1/2" @ 3367

CO 3364 1/2; 24/3348-54

Lost ld.

Tried Frac; Hole Full Wtr.

D & A

Anh. 716'; Tp. 2618'; H. 2914';

Tr. 2935'; BL. 3010'; L. 3025';

A. 3344'

TD 3369'

ABANDONED

County Barton Elev. 11W
Sec. 15 Twp. 18S Rge. 11W
Company Grant Oil Co.
Farm Name Redetzke "C" No. 1

TOPS	DEPTH	LOG	DATUM
Anh.			
Tp.			
H.			
Tr.			
Dg.			
Bl.			
L.			
K.C.			
B.K.C.			
Ce.			
C.			
M.			
M.			
K.			
Mz.			
Ma.			
V.			
S.			
S.			
A.			
R.			
Pe.			
G.			
T.D.			

Loc. in Sec. NW NW NE
DS - NE $\frac{1}{4}$
Geol. _____
Contr. Walters
Pool Esfeld

6
FIRST REPORT

Date Comm. JUN 20 '56
MIRT

[Handwritten signature and notes]

Co.
Lse.
No.
Sec.
T.
R.

County BartonElev. 1883Sec. 15Twp. 16SRge. 11WCompany Grant Oil Co.Farm Name Redetzke "C"No. 1

TOPS	DEPTH	LOG	DATUM	Loc. in Sec.
Anb.	716			NW NW NE
Tr.	2618			DS - NE $\frac{1}{2}$
H.	2914			
Tr.	2935			
Dg.				
Bl.	3010			
L. E	3025			
K.C.				Geol.
B.K.C.				Contr.
Ce.				Walters
C.				
M.				Pool
M.				Esfeld
K.				
Mz.				
Mo.				
V.				
S.				
S.				
A.	3344			ABANDONED
R.				JUL 25 1956
Pe.				
G.				
TD.	3369			

Date Comm.

MIRT JUN 27 '56 6-18-56 8⁵/₈ 188

ID 2707 JUL 3 '56 DST?

DST 3348-69 1 hr 120' OCM dwt

60' OCM + 80' oil + 40' water 870/20"

5¹/₂ @ 3367 JUL 11 '56 JUL 18 '56 CO. 3364¹/₂24/3348-54 1¹/₂ Lost Ld. Tried

Frac. Hole Full with

D&A ~~Chart~~ JUL 25 '56