


Cowley

KANSAS

SECTION 7 TOWNSHIP 32S RANGE 8E

WELL NO. #1 Jarvis "D"

COMPANY McNeish & Gralapp

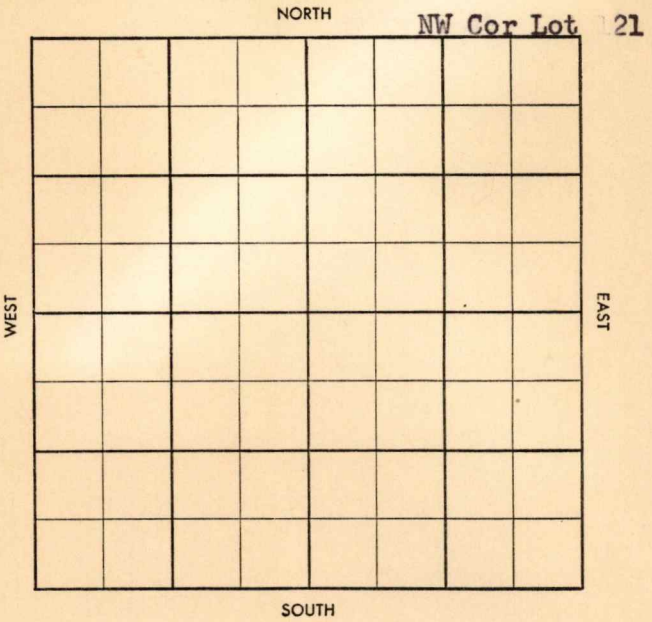

Twp. ~~X~~ Pool ~~X~~
Co. ~~X~~ Facet ~~X~~

S-513-B

County <u>Cowley</u> Elev. _____				Co.	
Sec. <u>7</u> Twp. <u>32</u> Rge. <u>8E</u>					
Company <u>McNeish & Gralapp</u>					
Farm Name <u>Jarvis "D"</u> No. <u>4</u>					
TOPS	DEPTH	LOG	DATUM	Loc. in Sec. _____	Lse.
Anh. _____				<u>NW Cor Lot 21</u>	
Tp. _____					
H. _____					
Tr. _____					
Dg. _____					
B.L. _____					
L. _____					
K.C. _____				Geol. _____	
B.K.C. _____				Contr. _____	
Ce. _____				<u>Watson #2</u>	
C. _____					
M. _____				Pool _____	
M. _____				<u>Windsor</u>	
K. _____					
Mz. _____					
Mq. _____					
V. _____					
S. _____					
S. _____					
A. _____					
R. _____					
Pf. _____					
G. _____					
T.D. _____					
Date Comm. <u>5/31/58</u>				No.	
<u>8" @ 200, WOC</u>					
				Sec.	
				T.	
				R.	

JUN 3 1958
FIRST REPORT

Twp. ~~XXXX~~ Pool ~~XXXX~~
 Co. ~~XXXX~~ Facet ~~XXXX~~

S-513-B

County Cowley Elev. 1256 RB
 Sec. 7 Twp. 32 Rge. 8E
 Company McNeish & Gralapp
 Farm Name Jarvis "D" No. 4

TOPS	DEPTH	LOG	DATUM	Loc. in Sec.
Anh. <u>107 an</u>	<u>1414</u>			<u>NW Cor Lot 21</u> <u>2970 FN</u> <u>8920 FE</u>
Tp. <u>Stol</u>	<u>1470</u>			
H. <u>Stol Li</u>	<u>1606</u>			
Tr. <u>Log sheet</u>	<u>1821</u>			
Dg. <u>Lay</u>	<u>1863</u>			
B.L.				
L.				
K.C.				Geol.
B.K.C.				Contr.
Ce.				<u>Watson #2</u>
C.				
M.				
M.				
K.				Pool
Mz.				<u>Windsor</u>
Mq.				
V.				
S.				
S.				
A.				
R.				
Pf.				
G.				
T.D.	<u>1905</u>			

JUN 18 '58
 COMPLETE

Date Comm 5/31/58
8" @ 200, WOC JUN 11 '58 cd 1869-1905 rec
5" 1890 JUN 18 '58 cd 1905 fac

est P 25 Bopd 1
Lay 1898-1905

