
FORM 51 25M 8-50 WESTERN Barton KANSAS

Section 25 Township 17 Range 14 W

Well No. # 1 Prose (B)

Company Bay Petr. & Anderson-Prichard

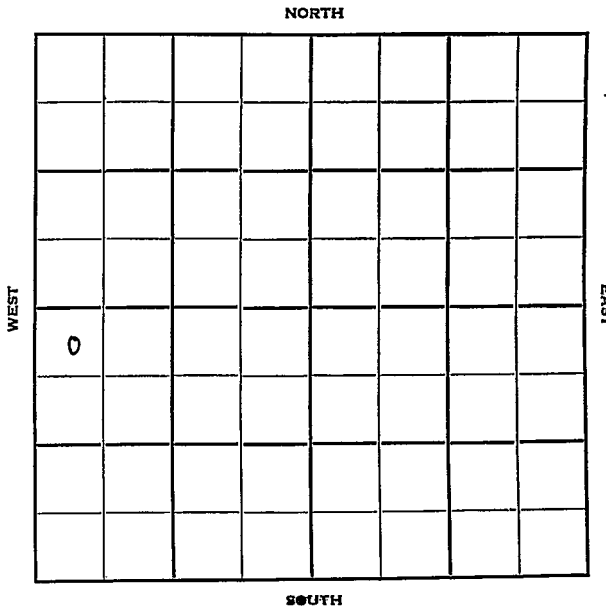

12

FORM 252-B
10M 11-50 PETROL

Barton KANSAS

Sec. 25 Twp. 17 R. 14W

Well No. #1 Prose (B) Farm

Bay Petroleum & Anderson Company

Contractor


330' Ft. from N. Line

Ft. from S. Line

330' Ft. from E. Line

Ft. from W. Line

NW NW SW

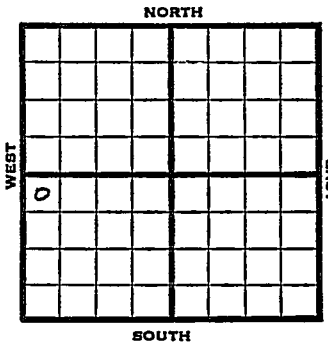

1951	Elev. 1874' REPORT
7/3	RUR
9/26	Spud 7-4-51 Oil well TD 3384 8" @ 706 Br. lm. 3120 Lans. 3131 DST 3132-47 open 45 min. Rec. 6' mud DST 3186-3210 open 1 hr. Rec. 30' mud DST 3259-71 open ½ Hr. Rec. 16' sgcm trace of oil Cong. 3334' Arb. 3364' DST 3364-73 open 45 min. Rec. 29' mud DST 3373-84 opne ½ hr. Rec. 432' mud & gassy oil 5" @ 3367 TD 3384 S/ 2½ boph 14 gwph Comp. 48 bopd 15% wtr COMPLETED

FORM 275 FOR SALE BY KANSAS BLUE PRINT CO.


County Barton State Kansas

Sec. 25 (Blk. Twp.) 17 (Sur. Rge.) 14W Map No.

Operator Bay Petroleum + Anderson-Prichard

Well No. 1 Farm Prose (B)

Elev. Location NW NW SW

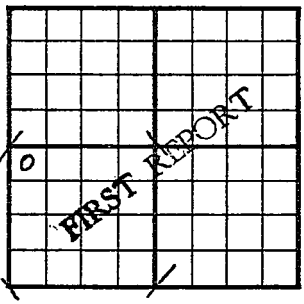

330 Ft. From N Line SW

330 Ft. From E Line Quarter

1st. Report JUL 3 1951

Completion

Remarks

~~Anderson-Prichard Cont~~

Spudding Date

Drlg. Data

RUR

J. E. TYRA

FORM 275 FOR SALE BY KANSAS BLUE PRINT CO.


County Barton State Kansas

Sec. 25 (Blk. Twp.) 17 (Sur. Rge.) 14W Map No.

Operator Bay Petroleum

Well No. 1 Farm Prose "B"

Elev. 1874 Location NW NW SW

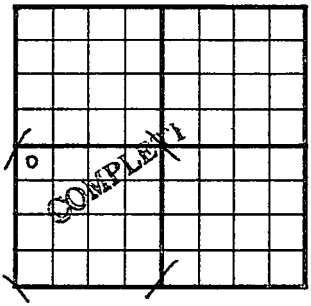

330 Ft. From N Line SW

330 Ft. From W Line Quarter

1st. Report

Completion SEP 26 1951

Remarks

Spudding Date 7-4-51

Drlg. Data Oil well TD 3384

8" @ 706 Br. lime 3120 Lans. 3131

DST 3132-47 open 45 min. Rec. 6' mud

DST 3186-3210 open 1 hr. Rec. 30' mud

DST 3259-71 open ½ hr. Rec. 16' sgcm

trace of oil Cong. 3334 Arb. 3364

DST 3364-73 open 45 min. Rec. 20' mud

DST 3373-84 open ½ hr. Rec. 432' mud

& gassy oil 5" @ 3367 TD 3384

S/ 2½ boph 14 gwph Comp. 48 bopd 15% w

J. E. TYRA