FORM 51 25M 8-50 WESTERN Barton KANSAS

Section 16 Township 16 Range 11 W

Well No. # 1 Redetzke

Company G-M-R Oil

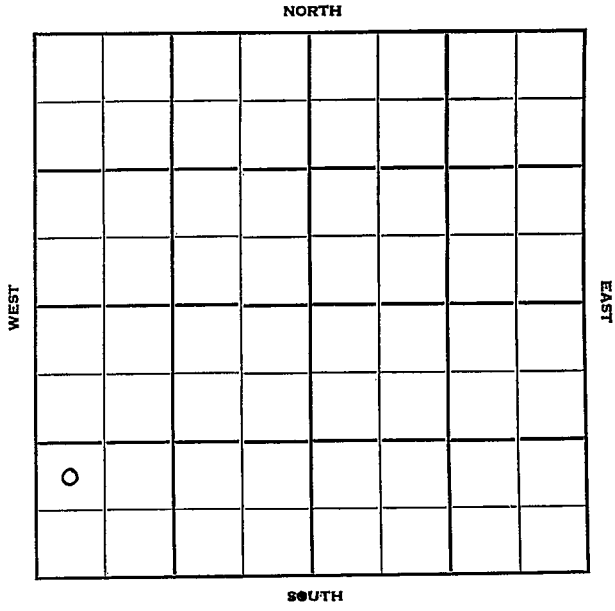

FORM 252-B
10M 11-50 PETROL

Barton KANSAS

Sec. 16 Twp. 16 R. 11 W

Well No. # 1 Redetzke Farm

G-M-R Oil Company

Braden Drlg. Contractor

Kraft-Prusa Pool

Ft. from N. Line

990 Ft. from S. Line

Ft. from E. Line

330 Ft. from W. Line

NW SW SW

Sinclair Farmout

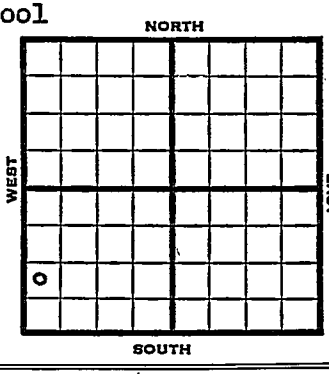

1951	Elev. 1886' REPORT
3/28	Location
5/2	Spud 3-26-51 Oil well TD 3339' 8" @ 540' Anhy 732' Heeb 2922' Tor. 2941' Doug 2953' Sd 2989-3010 Br. lime 3018' Lans. 3040' DST 3042-60 open ½ hr. rec 10' mud SO 3070-74, 3094-96', 3175-79', 3211-22', Cong 3315', Cong sd 3321', Cored 3327-29, rec 2' sd TD 3329' 5" @ 3329' 16/3316-20 16/3280-84 24/3264-70 20/3249-54 1000 A 24/3172-78 500 A S/1 BO 3 BWPH PB 3016' 22/3038-44 500 A S/ 8 BW 1 BOPH SP 3028' 4/3017-21 10/2970-80 1½ BWPH 8/2936-44 no inc. 11/2880-88 water Arb. 3328' CO to 3336' S/5 BO 8 BWPH DD 3339' Comp. 65 BOPD **COMPLETED**

FORM 275 FOR SALE BY KANSAS BLUE PRINT CO.

County Barton State Kansas

Sec. 16 (Blk. Twp.) 16 (Sur. Rge.) 11W Map No.

Operator G-M-R Oil

Well No. 1 Farm Redetzke

Elev. Location NW SW SW

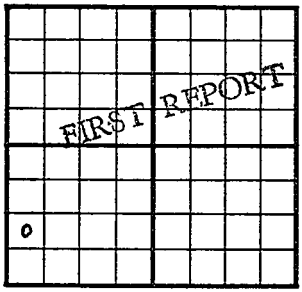

990 Ft. From S Line SW

330 Ft. From W Line Quarter

1st. Report MAR 28 1951

Completion

Remarks Sinclair farmout

Braden Drlg. - Contr.

Spudding Date

Drlg. Data Kraft-Prusa Pool

Location

J. E. TYRA

FORM 275 FOR SALE BY KANSAS BLUE PRINT CO.

County Barton State Kansas

Sec. 16 (Blk. Twp.) 16 (Sur. Rge.) 11W Map No.

Operator G-M-R Oil

Well No. 1 Farm Redetzke

Elev. 1886 Location NW SW SW

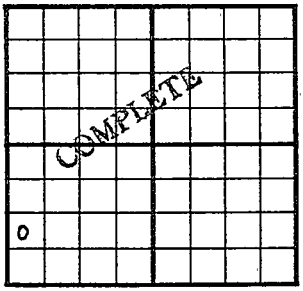

990 Ft. From S Line SW

330 Ft. From W Line Quarter

1st. Report

Completion MAY 2 1951

Remarks Kraft-Prusa Pool

Braden Drlg. - Contr.

Spudding Date 3-26-51

Drlg. Data Oil well TD 3339

8" @ 540 Anhy 732 Heeb. 2922

Tor. 2941 Doug. 2953 Sd. 2989-3010

Br. lime 3018 Lans. 3040 DST 3042-60

open ½ hr. Rec. 10' mud SO 3070-74

3094-96 3175-79 3211-22 Cong. 3315

Cong. sd. 3321 Cored 3327-29 Rec. 2' sd.

TD 3329 5" @ 3329 16/ 3316-20 16/ 3280

84 24/ 3264-70 20/ 3249-54 1000 A

24/ 3172-78 500 A S/ 1 bo 3 bwph

PB 3016 22/ 3038-44 500 A S/ 8 bw

1 boph SP 3028 4/ 3017-21 10/ 2970-80

1½ bwph 8/ 2936-44 no inc. 11/ 2880-88

water Arb. 3328 CO to 3336 S/ 5 bo

8 bwph DD 3339 Comp. 65 bopd

J. E. TYRA