

Section 8 Township 32 Range 8 EWell No. # 1 WalkerCompany Gough Davis

NORTH

WEST

EAST

SOUTH

0

Cowley KANSAS

SEC.	TWP.	R.
8	32	8E ✓

WELL NO. 1 Walker FARM

COMPANY

CONTRACTOR Gough Davis


Uhl
Wildcat

_____ Ft. from N. Line

330 _____ Ft. from S. Line

330 _____ Ft. from E. Line

_____ Ft. from W. Line

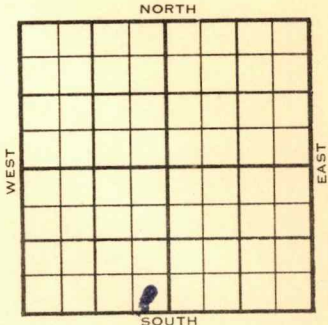


SE SE SW
Texas - DHM & BHM

1954	ELEVATION	REPORT
------	-----------	--------

4/21	Drlg.
5/12	D & A
	TD 2739'
	8" @ 85'
	Lans 1625', KC 1848', Layton 1875'
	DST 1881'-1900' opn 1 hr, rec 30' Mud
	320# KC 2050', B KC 2170' Marm 2253'
	Peru 2288', Skinn er 2540' Red Fork
	2622', Miss 2693'
	TD 2739'
	D & A

ABANDONED

County Cowley State Kansas
Sec. 8 (Blk.) 32 (Sur.) 8E Map No.
(Twp.)
Operator Gough Davis
Well No. 1 Farm Walker
Elev. Location SE SE SW

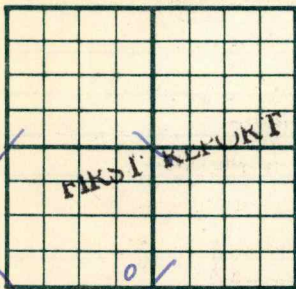

330 Ft. From S Line SW
330 Ft. From E Line Quarter
1st. Report APR 21 1954


Completion

Remarks Texas - DHM & BHM
Uhl - Contr.

Spudding Date

Drlg. Data Wildcat
drlg.

County Cowley State Kansas
 Sec. 8 (Blk. 32 (Sur. 8E Map No.
 Twp.) Rge.)
 Operator Gough Davis
 Well No. 1 Farm Walker
 Elev. Location SE SE SW

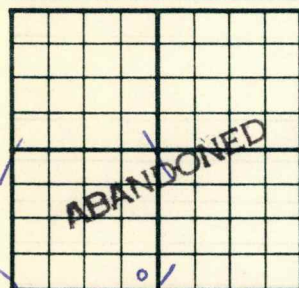

330 Ft. From S Line SW
330 Ft. From E Line Quarter

1st. Report

Completion MAY 12 1954

Remarks Wildcat

Uhl - Contr.

Spudding Date

Drlg. Data D & A TD 2739

8" @ 85 Lans. 1625 KC 1848

Layton 1875 DST 1881-1900 open 1 hr.

Rec. 30' mud 320# KC 2050 B KC 2170

Marm. 2253 Peru. 2288 Skinner 2540

Red Fork 2622 Miss. 2693 TD 2739

D & A

J. G. McGEHEE