


Cowley

KANSAS

SECTION 17 TOWNSHIP 32S RANGE 8E

WELL NO. #1 Walker

COMPANY Wakefield

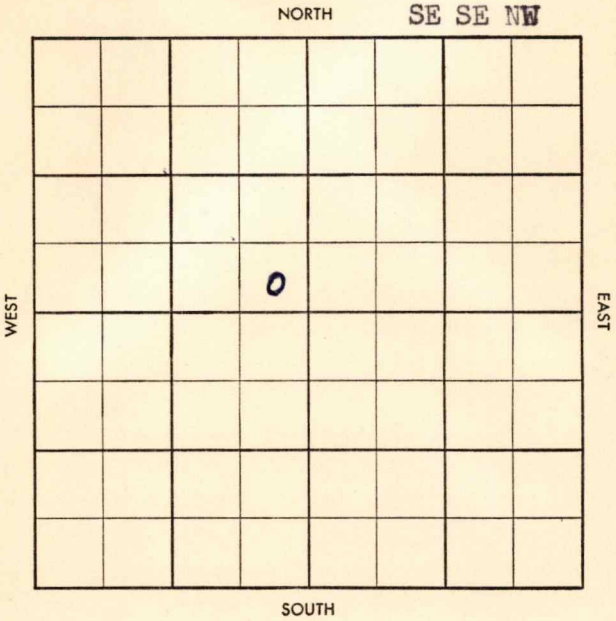

WILDCAT

S-513-B

County Cowley Elev. _____
 Sec. 17 Twp. 32 Rge. 8E
 Company Wakefield
 Farm Name Walker No. 1

TOPS	DEPTH	LOG	DATUM
Anh.			
Tp.			
H.			
Tr.			
Dg.			
B.L.			
L.			
K.C.			
B.K.C.			
Ce.			
C.			
M.			
M.			
K.			
Mz.			
Mq.			
V.			
S.			
S.			
A.			
R.			
Pf.			
G.			
T.D.			

Loc. in Sec. SE SE NW

Geol. _____
 Contr. _____
 Co. Tools _____

Pool _____
Wildcat

FIRST REPORT

FEB 26 '58

Date Comm. _____ (Texas - DHC, Sun - DHC)
M I R T

Co.

Lse.

No.

Sec.

T.

R.

Twp. ~~_____~~ Pool ~~_____~~
 Co. ~~_____~~ Facet ~~_____~~

S-513-B

County Cowley Elev. 1260 DF
 Sec. 17 Twp. 32 Rge. 8E
 Company Wakefield
 Farm Name Walker No. 1

TOPS	DEPTH	LOG	DATUM
Anh. <u>Haskin</u>		<u>1316</u>	
Tp. <u>2+21</u>		<u>1354</u>	<u>94</u>
H. <u>Lay 2</u>		<u>1740</u>	<u>480</u>
Tr.			
Dg. <u>KG</u>		<u>1882</u>	<u>622</u>
B.L. <u>50</u>		<u>1947</u>	<u>876</u>
L. <u>DSW</u>		<u>2248</u>	<u>988</u>
K.C.			
B.K.C.			
Ce.		<u>2328</u>	<u>1068</u>
C. <u>SKINNER</u>		<u>2443</u>	<u>1183</u>
M.		<u>2598</u>	<u>1338</u>
M.			
K.			
Mz.			
Mq.			
V.			
S.			
S.			
A.			
R.			
Pf.			
G.			
T.D.	<u>2660</u>		

Loc. in Sec. SE SE NW
 Geol. X
 Contr. Co. Tools
 Pool Wildcat
 ABANDONED
 APR 2 '58

Date Comm. 3-25-58 (Texas - DHC, Sun - DHC)
M I R T MAR 12 '58 MAR 19 '58 MAR 26 '58 APR 2 '58
8" 120/ crd st
D & A