
FORM 51 25M 8-50 WESTERN Barton KANSAS

Section 16 Township 16 Range 11 W

Well No. # 2 Redetzke

Company G-M-R Oil

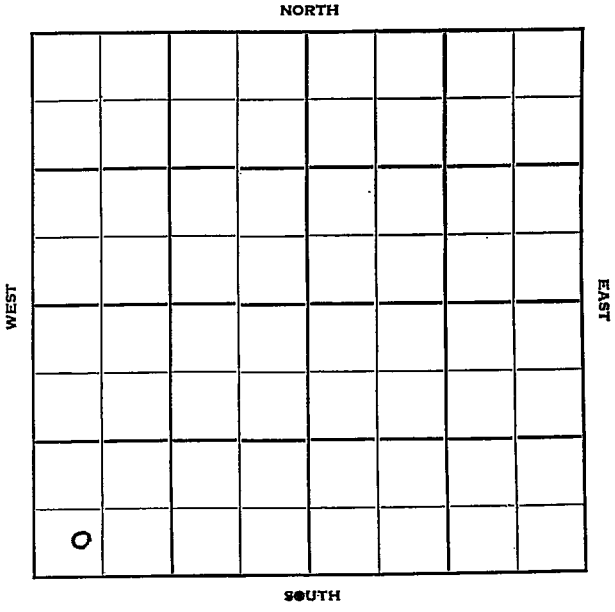

FORM 252-B
10M 11-50 PETROL

Barton KANSAS

Sec. 16 Twp. 16 R. 11 W

Well No. # 2 Redetzke Farm

G-M-R Oil Company

Contractor

Kraft-Prusa


Ft. from N. Line

330 Ft. from S. Line

Ft. from E. Line

430 Ft. from W. Line

C S L SW SW

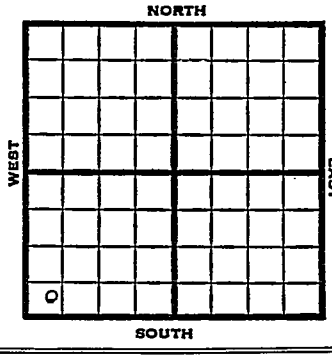

1951	Elev. 1886' REPORT
5/23	Location
6/27	Spud 5-25-51 Oil Well TD 3311 8" @ 537 Top 2668 Br lime 3008 KC 3026 DST 3168-3212 opn 1 hr Rec. 90' gcm Arb. 3306-09 5" @ 3309 DD 3311 S/2 boph 500 A Comp. 25 bopd COMPLETED

FORM 275 FOR SALE BY KANSAS BLUE PRINT CO.


County Barton State Kansas

Sec. 16 (Blk. Twp.) 16 (Sur. Rge.) 11W Map No.

Operator G-M-R Oil

Well No. 2 Farm Redetzke

Elev. 1886 Location C S L SW SW

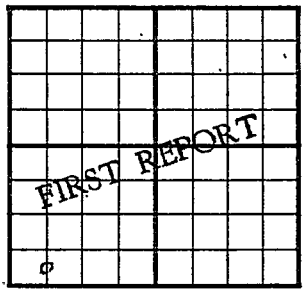

330 Ft. From S Line SW

430 Ft. From W Line Quarter

1st. Report MAY ? 3 1951

Completion

Remarks

Spudding Date

Drlg. Data Kraft-Prusa Pool

Location

J. E. TYRA

FORM 275 FOR SALE BY KANSAS BLUE PRINT CO.


County Barton State Kansas

Sec. 16 (Blk. Twp.) 16 (Sur. Rge.) 11W Map No.

Operator G-M-R Oil

Well No. 2 Farm Redetzke

Elev. 1886 Location C S L SW SW

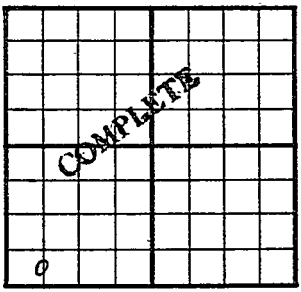

330 Ft. From S Line SW

430 Ft. From W Line Quarter

1st. Report

Completion JUN 27 1951

Remarks Kraft-Prusa Pool

Spudding Date 5-25-51

Drlg. Data Oil well TD 3311

8" @ 537 Top. 2668 Br. lime 3008

KC 3026 DST 3168-3212 open 1 hr.

Rec. 90' gcm Arb. 3306-09 5" @ 3309

DD 3311 S/ 2 boph 500 A Comp. 25 bopd

J. E. TYRA