


Map No. **KANSAS** Sec. 19 Twp. 32 R. 8^E
Well No. F-Adam Farm
Roth & Tourat Company

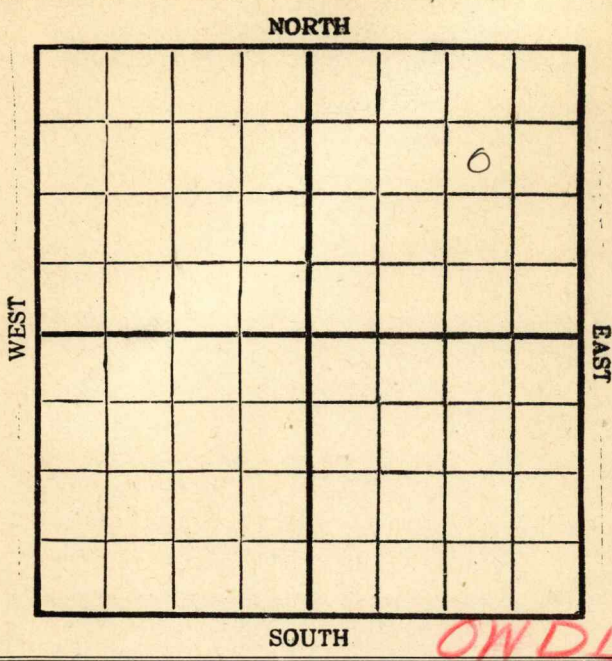

Location _____
Drilling Remarks _____

Rig Up _____
Drilling Remarks _____

RECORD


Cased _____ in. _____ ft.
Sand _____
Gas _____
Oil _____
Total Depth _____

PRODUCTION

1st 24 hrs. Nat. _____
1st 24 hrs. after shot _____
Gas _____ cu. ft. _____
Dry Hole _____
Abandoned _____

Map No. KANSAS Sec. 19 Twp. 32 R. 8^E
 Well No. 1- Adam Farm
Roth & Tourat Company

NORTH

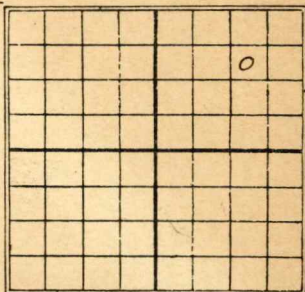

WEST

EAST

SOUTH

990 Ft. from N. Line

_____ Ft. from S. Line

990 Ft. from E. Line

1930 Ft. from W. Line

Date

REPORT

2/26	Rod
3/5	—
3/2	Rig
3/19	Rig up
3/26	Spdg 250
4/2	Only 950'
4/9	" 1225'
4/16	S.D. 1250'
4/23	8" 1600 - T.D. 1825'
4/30	Spdg 1850'
5/7	Saled 2130 - 40 show thru' N & W - Fsg. 2147'
5/14	—
5/21	—
5/28	—
6/4	—
6/11	—
6/18	Spdy. line 2130 - 50 show - Est. 17A gas Rng. 6" (over)

6/25 - Shaw oil 2130-50
Top sand 2230 HFW
TD 2360

Dry & abandon
1930 **OWDD**

7/9 - Old TD 2360

Chat 2634-55 dry
dry 2925'

7/16 - " 3020'

7/23 - Sand 3035-42'
HFW - will plug
back to gas
sand 1768-1778

7/30 —

8/6 —

8/13 - T.D. 3042'

P.B. to Gas sand 1768-78

1 M gas

Comp.

3 **KANSAS** Sec. 19 Twp. 32 R. 8 ^E

Well No. 1 Adam
Roth & Jaurat Company

Contractor

FIRST REPORTS

990 Ft. from N. Line

Ft. from S. Line

990 Ft. from E. Line

Ft. from W. Line

SECTION PLAT

			0

Location Pro G

Rig up

Drilling and Remarks:

RECORD

Cased in., ft.

Sand

Gas

Oil

Total Depth

PRODUCTION

1st 24 hrs. Nat.

1st 24 hrs. after shot

Gas Cu. Ft.

Dry Hole

Abandoned

Date

FEB 26 1930

192

CHAS. L. SHERWOOD

Scout

Cowley

KANSAS

Map No. _____ Sec. 19 Twp. 32 R. 8

Well No. 1 adam

Proth + Taurat

Company _____

Contractor _____

COMPLETE

SECTION PLAT

			0

990 Ft. from N. Line

_____ Ft. from S. Line

990 Ft. from E. Line

_____ Ft. from W. Line

ABANDONED

Location _____

RECORD

Cased _____ in., _____ ft.

Sand _____

Gas _____

Oil _____

Total Depth 2360'

Drilling and Remarks:

Show oil 2130-50

top sand 2230'

HFW

PRODUCTION

1st 24 hrs. Nat. _____

1st 24 hrs. after shot _____

Gas _____ Cu. Ft.

Dry Hole ☒Abandoned ☒

Date

JUN 25 1930

19

CHAS. L. SHERWOOD

Scout

Cowley
 3 **KANSAS** Map No. _____ Sec. *19* Twp. *32* R. *8*^E

Well No. *1* *Adams*
Roth & Faurat Company

Contractor _____

FIRST REPORTS**SECTION PLAT***990* Ft. from N. Line

_____ Ft. from S. Line

990 Ft. from E. Line

_____ Ft. from W. Line

"Shd keep deeper"

			<i>0</i>

Location _____

Rig up *JD was 2300*

Drilling and Remarks:

*Chat 2634-2655 Dry**Dry 2925'***RECORD**

Cased _____ in., _____ ft.

Sand _____

Gas _____

Oil _____

Total Depth _____

PRODUCTION

1st 24 hrs. Nat. _____

1st 24 hrs. after shot _____

Gas _____ Cu. Ft.

Dry Hole _____

Abandoned _____

Date

*JUL 9 1930***CHAS. L. SHERWOOD**

19

Scout

Cowley

Map No. **KANSAS** Sec. 19 Twp. 32 R. 8Well No. 1 adamsRoth & Faurot

Company

Contractor

SECTION PLAT

COMPLETE990 Ft. from N. Line

_____ Ft. from S. Line

990 Ft. from E. Line

_____ Ft. from W. Line

			0

Location _____

Rig up _____

Drilling and Remarks

PB to gas sand
1768-1778'

gas well.

RECORD

Cased _____ in., _____ ft.

Sand _____

Gas _____

Oil _____

Total Depth 3042

PRODUCTION

1st 24 hrs. Nat. _____

1st 24 hrs. after shot _____

Gas 1 M Cu. Ft.

Dry Hole _____

Abandoned _____

Date

AUG 13 1930

19

CHAS. L. SHERWOOD

Scout