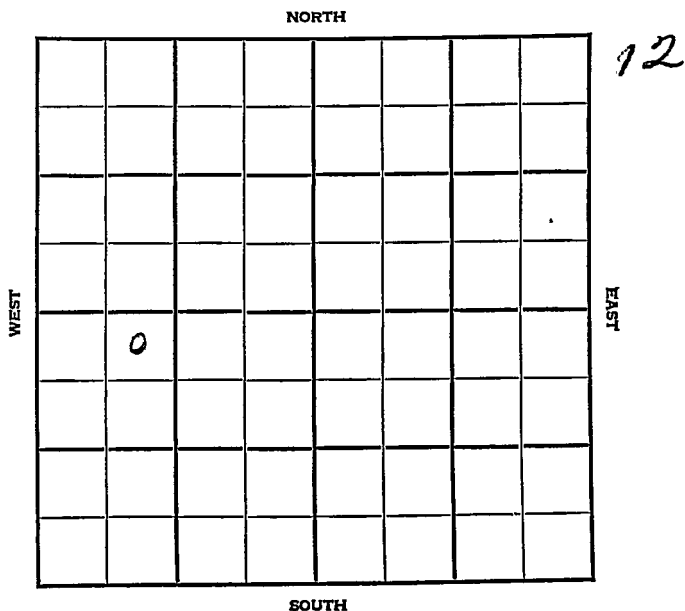



Section 28 Township 17 Range 14WWell No. #1 ElliottCompany Harbar et al.

Sec. 28 Twp. 17 R. 14WWell No. #1 Elliott FarmHarbar et al Company

Carroll

330' Ft. from N. Line Ft. from S. Line Ft. from E. Line990' Ft. from W. Line

NE NW SW

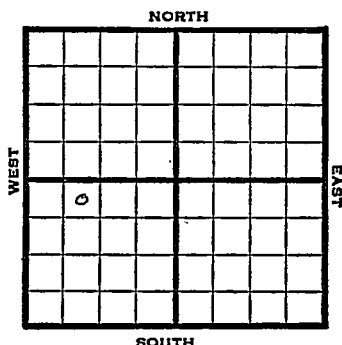

1948 Elev. 1861' REPORT

5/12 Surface Hole

5/19 13" @ 163'
Drig. 1305'

5/26 Fsg 2690'

6/1 Lansing 3088'
Arbuckle 3382'
5" @ 3383'
TD 3390'
RUST

6/9 58 shots 3170-78- 250 acid

6/16 Plug 3140 - 48 shots 3102-07
1150' oil 13 hrs

6/23 " "

6/29 " "

7/8 Lans. 3088'
Arbuckle 3382'
5" @ 3382'
Perf Lans.
Acid 250
Pump 50 oil Pot.
Gr. 37°
TD 3390'**COMPLETED**

Map No. _____ Sec. 28 Twp. 17 R. 14W

Well No. 1 Elliott

Harbar et al. Company

FIRST REPORT

Contractor

NE NW SW

SECTION PLAT

330 Ft. from N. Line

_____ Ft. from S. Line

_____ Ft. from E. Line

990 Ft. from W. Line

o			

Barton County

Location _____

Rig up _____

Drilling and Remarks:

surface hole

RECORD

Cased _____ in., _____ ft.

Sand _____

Gas _____

Oil _____

Total Depth _____

PRODUCTION

1st 24 hrs. Nat. _____

1st 24 hrs. after shot _____

Gas _____ Cu. Ft.

Dry Hole _____

Abandoned _____

Date

MAY 12 1948

19

S. J. LEWIS Scout

Carroll Pool

Form 26—200 Bks.—1-48—Palace
Kansas

Map No. 73 Sec. 28 Twp. 17 R. 14W

Well No. 1 Elliott

Harbar etal.

Company

COMPLETE

Contractor

NE NW SW

E11861
SECTION PLAT

330 Ft. from N. Line

Ft. from S. Line

Ft. from E. Line

990 Ft. from W. Line

Barton County

RECORD

Location _____

Cased _____ in., _____ ft.

Rig up _____

Sand _____

Drilling and Remarks:

Gas _____

Loss 8088

Oil _____

Cr 8382

Total Depth 2380

5" @ 3382

PRODUCTION

Perf. Loss.

1st 24 hrs. Nat. _____

250 ac. 1/2

1st 24 hrs. after shot _____

Produce 50 oil Prod

Gas _____ Cu. Ft.

Dry Hole _____

Abandoned _____

Date

JUL 8 1948

S. J. LEWIS Scout