


Chautauqua

KANSAS

Section.....1.....Township.....32.....Range 10-E.....

Well Number 2 Glasscock.....

Company.....Griffin & Bell.....

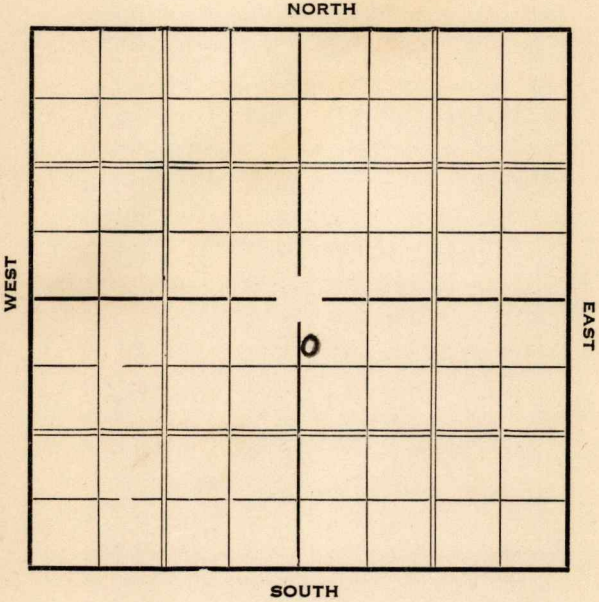

Map No. \_\_\_\_\_ Sec. 1 Twp. 32 R. 10-E

Well No. #2 Glasseock Farm \_\_\_\_\_


Griffin & Bell Company \_\_\_\_\_

500 Ft. from N. Line

\_\_\_\_\_ Ft. from S. Line

\_\_\_\_\_ Ft. from E. Line

150 Ft. from W. Line

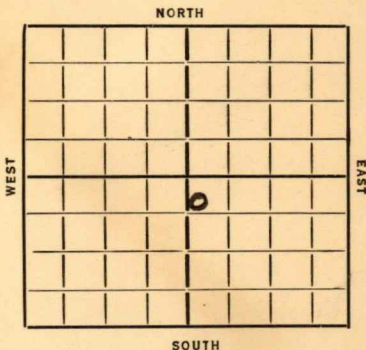

Date 1936

REPORT

12/16 Sil. 2278'. 3000 acid.  
50 bbls.

**FIRST REPORTS**

*and*

**COMPLETED**

*Chautauqua* KANSAS

Map No. 4 Sec. 1 Twp. 32 R. 10E

Well No. 2 Glasscock

Griffin & Bell Company

Contractor

SECTION PLAT

		0	

500 Ft. from N. Line

\_\_\_\_\_ Ft. from S. Line

\_\_\_\_\_ Ft. from E. Line

150 Ft. from W. Line

FIRST REPORT

COMPLETED

Location \_\_\_\_\_

Rig up \_\_\_\_\_

Drilling and Remarks:

*Sil 2278*

*3000 acid*

*50 x 1/2*

RECORD

Cased \_\_\_\_\_ in., \_\_\_\_\_ ft.

Sand \_\_\_\_\_

Gas \_\_\_\_\_

Oil \_\_\_\_\_

Total Depth 2282

PRODUCTION

1st 24 hrs. Nat. \_\_\_\_\_

1st 24 hrs. after shot \_\_\_\_\_

Gas \_\_\_\_\_ Cu. Ft.

Dry Hole \_\_\_\_\_

Abandoned \_\_\_\_\_

Date

DEC 16 1936

19

S. J. LEWIS

Scout