


Section 17 Township 25 Range 5-E

Well No. #5 Robinson

Company T. S. Dustin et al

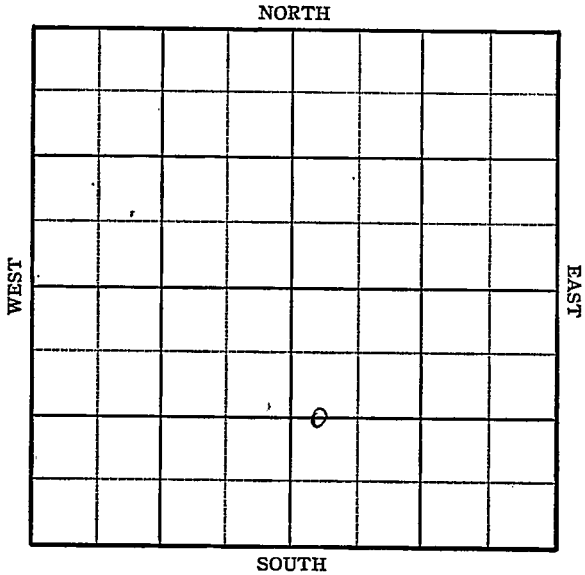

KANSAS

Butler County ✓

Sec. 17 Twp. 25 R. 5E

Well No. #5 Robinson Farm

T. S. Dustin et al Company

Miscellaneous


1320 Ft. from N. Line

_____ Ft. from S. Line

_____ Ft. from E. Line

330 Ft. from W. Line

CWL W/2 SE

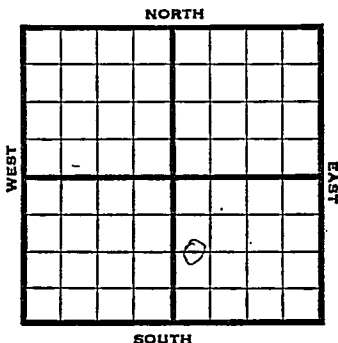

1946

Elev. 1378

REPORT

3/6

Machine

3/13

Spud.

3/21

15" - 175'

Drlg. 445'

3/28

Drlg. 1345'

4/4

12" @ 895

10" @ 1660

Drlg. 2009'

4/10

Miss 2501

5" @ 2501

TD 2565

PB 2534 CO

4/16

" "

4/24

Mis s. 2496

7" @ 2501

TD 2563'

Pump 20 Pot.

Grav. 39.0

COMPLETED

Kansas Pool Name Miscellaneous

KANSAS
 Map No. 14 Sec. 17 Twp. 25 R. 5E

Well No. 5 Robinson

T. S. Dustin etal Company

FIRST REPORT Contractor

C W L W $\frac{1}{2}$ SE

SECTION PLAT

		o	

1320 Ft. from N. Line

_____ Ft. from S. Line

_____ Ft. from E. Line

330 Ft. from W. Line

Butler County

Location _____

Rig up _____

Drilling and Remarks:

machine

RECORD

Cased _____ in., _____ ft.

Sand _____

Gas _____

Oil _____

Total Depth _____

PRODUCTION

1st 24 hrs. Nat. _____

1st 24 hrs. after shot _____

Gas _____ Cu. Ft.

Dry Hole _____

Abandoned _____

Date

MAR 6 1946
 19

S. J. LEWIS Scout

KANSAS

Kansas Pool Name Miscellaneous

Map No. 14 Sec. 17 Twp. 25 R. 5E

Well No. 5 Robinson

T. S. Dustin et al. Company

COMPLETED

Contractor

C W L W $\frac{1}{2}$ SE

E. 137
SECTION PLAT

1320 Ft. from N. Line

 Ft. from S. Line

330 Ft. from E. Line

 Ft. from W. Line

Butler County

Location _____

Rig up _____

Drilling and Remarks:

Misc 2496
7° C 2501
Pump 20 PD

39-9-1

RECORD

Cased _____ in., _____ ft.

Sand _____

Gas _____

Oil _____

Total Depth 2563

PRODUCTION

1st 24 hrs. Nat. _____

1st 24 hrs. after shot _____

Gas _____ Cu. Ft.

Dry Hole _____

Abandoned _____

Date

APR 24 1946 19

S. J. LEWIS Scout