


KANSAS

Barton

Section 28 Township 17S Range 14W

Well No. #2 Elliott

Company Harbar Drlg.

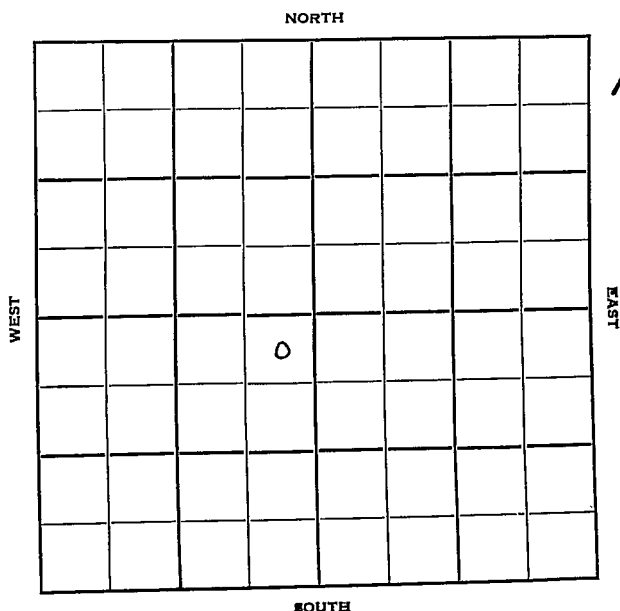

Sec. 28 Twp. 17 R. 14-WWell No. #2 Elliott Farm _____

Harbar Drlg

Company _____


Cont. Harbar

330 Ft. from N. Line

_____ Ft. from S. Line

330 Ft. from E. Line

_____ Ft. from W. Line

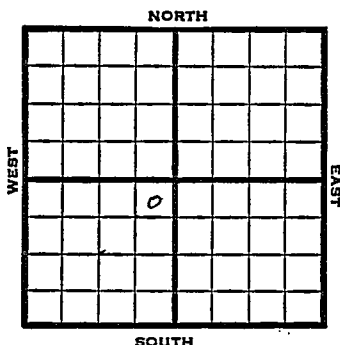

NE SW

1949

REPORT

10/12 8"@ 840'
10/19 Drlg 2839'
10/26 TD 3251'
5" @ 3250' . .
11/1 Arbuckle 3350'
TD 3363'
Acid 1000
Swb 2 bbls oil PH
11/9 "
11/16 "
11/23 "
11/29 "
12/7 "
12/14 "
12/21 "
12/28 "
1950
1/4 TD 3363'
8"@ 840'
Anhy 841'
5"@ 3250'
Arb. 3350'
1250 acid
Pump 25 Oil
No wtr.
Comp

COMPLETED

Map No. _____ Sec. 28 Twp. 17 R. 14W

Well No. 2 Elliott

_____ Harbar Drlg. _____ Company

_____ Harbar _____ Contractor

NE SW

**FIRST REPORT
SECTION PLAT**

330 Ft. from N. Line

_____ Ft. from S. Line

330 Ft. from E. Line

_____ Ft. from W. Line

Barton County

Location _____

Rig up _____

Drilling and Remarks:

8" @ 840

RECORD

Cased _____ in., _____ ft.

Sand _____

Gas _____

Oil _____

Total Depth _____

PRODUCTION

1st 24 hrs. Nat. _____

1st 24 hrs. after shot _____

Gas _____ Cu. Ft.

Dry Hole _____

Abandoned _____

Date

OCT 12 1949 19

S. J. LEWIS

Scout

Kansas

Carroll Pool

Map No. _____ Sec. 28 Twp. 17 R. 14W

Well No. 2 Elliott

Harbar

Company

Contractor

NE SW


SECTION PLAT

330 Ft. from N. Line

Ft. from S. Line

330 Ft. from E. Line

Ft. from W. Line

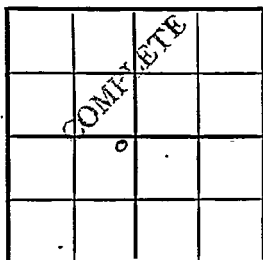

Barton County

Location

Rig up

Drilling and Remarks:

8" @ 840

anhy 841

5" @ 3250

arb. 3350

1250 acid

Pump 25 oil no water

RECORD

Cased _____ in., _____ ft.

Sand _____

Gas _____

Oil _____

Total Depth 3363

PRODUCTION

1st 24 hrs. Nat. _____

1st 24 hrs. after shot _____

Gas _____ Cu. Ft.

Dry Hole _____

Abandoned _____

Date

JAN 4 1950

19

J. E. Lura Scout