

Butler

KANSAS

SECTION 17 TOWNSHIP 25 RANGE 5E


WELL NO. #4 Robinson

COMPANY Wilson Production "B"

NORTH

WEST

EAST

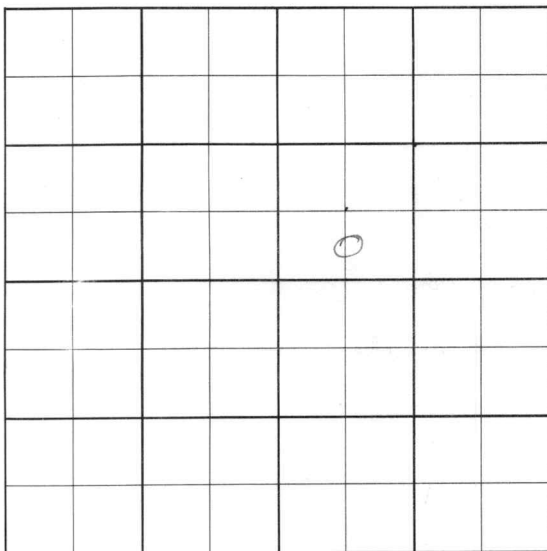

SOUTH

SEC.	17	TWP.	25	R.	5E
------	----	------	----	----	----

WELL NO. #4 Robinson FARM

COMPANY Wilson Production "B"

CONTRACTOR

El Dorado


_____ FT. FROM N. LINE

_____ FT. FROM S. LINE

_____ FT. FROM E. LINE

_____ FT. FROM W. LINE

S/2 SW NE

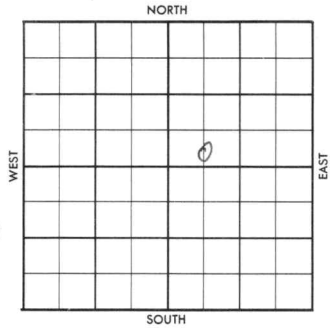

1956	ELEVATION	REPORT
------	-----------	--------

9-5 RUCT

County Butler Elev. _____
 Sec. 17 Twp. 25 Rge. 5E
 Company Wilson Production "B"
 Farm Name Robinson No. 4

TOPS	DEPTH	LOG	DATUM	Loc. in Sec.
Anh.				S/2 SW NE
Tp.				
H.				
Tr.				
Dg.				
Bl.				
L.				Geol. _____
K.C.				Contr. _____
B.K.C.				
Ce.				
C.				
M.				Pool _____
M.				
K.				
Mz.				<u>ElDorado</u>
Ma.				
V.				
S.				
S.				
A.				
R.				
Pe.				
G.				
T.D.				

SEP 5 1956
 FIRST REPORT

Date Comm.

RUCT

29

SEP 1 1956

Co.

Lsc.

No.

Sec.

T.

R.

County Butler Elev. 1338
 Sec. 17 Twp. 25 Rge. 5E
 Company Wilson Production "B"
 Farm Name Robinson No. 4

TOPS	DEPTH	LOG	DATUM	Loc. in Sec.
Anh.				S/2 SW NE
Tp.				
H.				
Tr.				
Dg.				
Bl.				
L.				Geol.
K.C. <u>Letorado</u>				Contr.
B.W. <u>3d</u>	<u>681</u>			
Ce.				
C.				
M.				Pool
M.				<u>ElBorado</u>
K.				
Mz.				
Me.				
V.				
S.				
S.				
A.				
R.				
Pe.				
G.				
TD.	<u>708</u>			

COMPLETE
 SEP 26 '56

Date Comm. SEP 12 '56 Pipe set SEP 19 '56
7" @ 681-1140 oil from
681-87 & 702-708 IB
2 1/2 Bailleurs Fluid ph 90 to
wt 4 me. SEP 26 '56 IB 4 1/2 B0
+ 40 Bwpd Pop P. 5
Bopd + 40 Bwpd.