


Shauqua

Map No. **KANSAS** Sec. 12 Twp. 32 R. 10^E

Well No. 2 Curran Farm

Griffin & Bell Company

NORTH

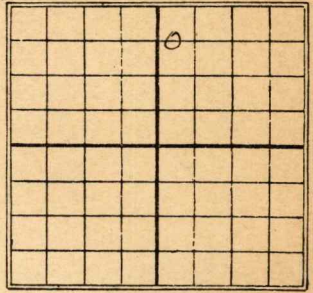

WEST

EAST

SOUTH

660 Ft. from N. Line

_____ Ft. from S. Line

_____ Ft. from E. Line

250 Ft. from W. Line

1930

Date

REPORT

Date	REPORT
5/28	Spdy
6/4	Shdy 915'
6/11	" 1360'
6/18	" 1700'
6/25	Sand 1645-72
	TD 1672
	shot 60 qt
	0 45 th barrel oil
	Comp.

Chautauqua

KANSAS

Map No. _____ Sec. 12 Twp. 32 R. 10^E

Well No. 2 *Curran*

Griffin ∇ *Bell* _____ Company

Contractor _____

FIRST REPORTS

SECTION PLAT

660 Ft. from N. Line

_____ Ft. from S. Line

_____ Ft. from E. Line

750 Ft. from W. Line

		0	

Location _____

Rig up _____

Drilling and Remarks:

Open

RECORD

Cased _____ in., _____ ft.

Sand _____

Gas _____

Oil _____

Total Depth _____

PRODUCTION

1st 24 hrs. Nat. _____

1st 24 hrs. after shot _____

Gas _____ Cu. Ft.

Dry Hole _____

Abandoned _____

Date

MAY 28 1930 19

CHAS. L. SHERWOOD

Scout

Chautauque

Map No. **KANSAS** Sec. 12 Twp. 32 R. 10

Well No. 4 Curran

McGinnis & Bell Company

Contractor

COMPLETE

SECTION PLAT

		o	

660 Ft. from N. Line

Ft. from S. Line

Ft. from E. Line

750 Ft. from W. Line

Location _____

Rig up _____

Drilling and Remarks:

66/45 Bls.

RECORD

Cased _____ in., _____ ft.

Sand 1645-1672

Gas _____

Oil _____

Total Depth 1672

PRODUCTION

1st 24 hrs. Nat. _____

1st 24 hrs. after shot _____

Gas _____ Cu. Ft.

Dry Hole _____

Abandoned _____

Date

JUN 25 1930

19

CHAS. L. SHERWOOD

Scout