


Shawtangua

Map No. **KANSAS** Sec. 12 Twp. 32 R. 10^E

Well No. 1- Jeanette Farm
Duffen & Bell Company

NORTH

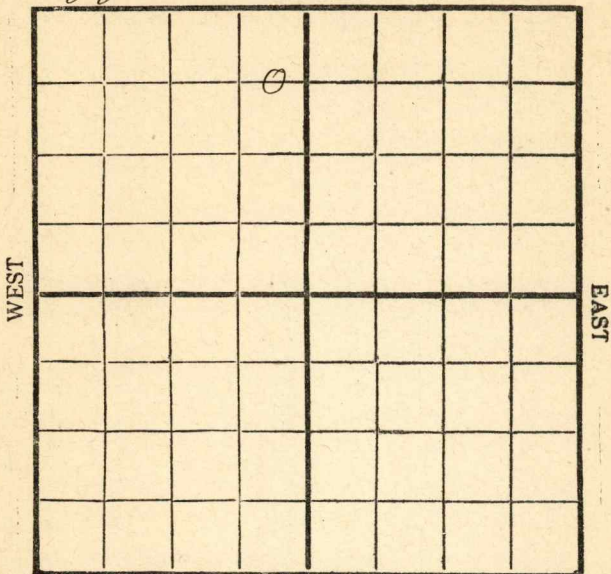

SOUTH

Location _____

Drilling Remarks _____

Rig Up _____

Drilling Remarks _____

RECORD

Cased _____ in. _____ ft.

Sand _____

Gas _____

Oil _____

Total Depth _____

PRODUCTION

1st 24 hrs. Nat. _____

1st 24 hrs. after shot _____

Gas _____ cu. ft. _____

Dry Hole _____

Abandoned _____

chantaugua

Map No. **KANSAS** Sec. 12 Twp. 32 R. 10^E

Well No. 1 Jeanette

Griffin & Bell Company

Contractor

FIRST REPORTS

660 Ft. from N. Line

Ft. from S. Line

330 Ft. from E. Line

Ft. from W. Line

SECTION PLAT

	0		

Location

Rig up

Drilling and Remarks:

Dlg 200'

RECORD

Cased in., ft.

Sand

Gas

Oil

Total Depth

PRODUCTION

1st 24 hrs. Nat.

1st 24 hrs. after shot

Gas Cu. Ft.

Dry Hole

Abandoned

Date

MAR 12 1930

192

CHAS. L. SHERWOOD

Scout

Chautauque

KANSAS

Map No. Sec. 12 Twp. 32 R. 10

Well No. 4 Jeanette

Guzzon & Bell Company

Contractor

COMPLETE

SECTION PLAT

660 Ft. from N. Line

Ft. from S. Line

330 Ft. from E. Line

Ft. from W. Line

	0		

Location

Rig up

Drilling and Remarks:

top hole 1653

85 Bls.

RECORD

Cased in., ft.

Sand 1653-1680

Gas

Oil

Total Depth 1680

PRODUCTION

1st 24 hrs. Nat.

1st 24 hrs. after shot

Gas Cu. Ft.

Dry Hole

Abandoned

Date

APR 2 1930

CHAS. L. SHERWOOD

192

Scout