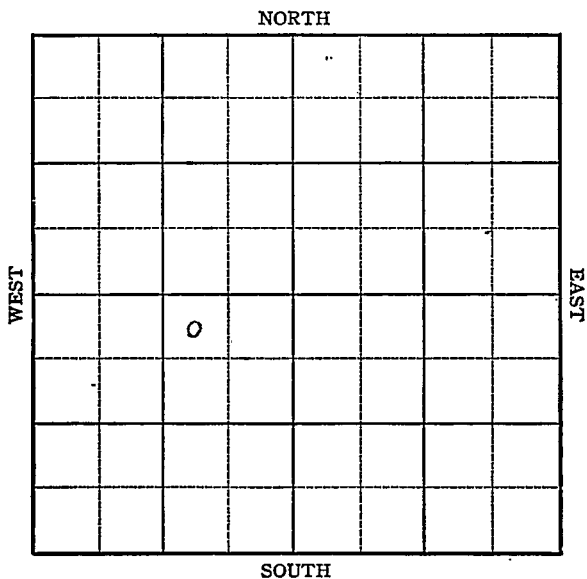


KANSAS

Butler county

Section 17 Township 25 Range 5-EWell No. RobinsonCompany Wilson Oil Company

KANSAS

Butler

Sec. 17 Twp. 25 R. 5E

Well No. #7 Robinson ~~6 Robinson~~ Farm

Wilson Oil Company

Miscellaneous


330 Ft. from N. Line

 Ft. from S. Line

990 Ft. from E. Line

 Ft. from W. Line

NORTH

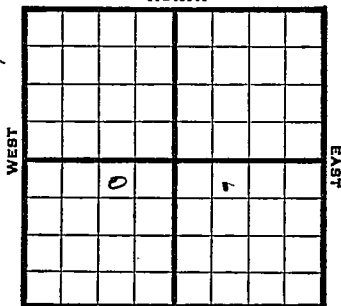

NW NE SW

1946

Elev. 1394'

REPORT

11/13

Rig

11/20

Drlg 100'

11/27

Drlg 200'

12/10

Lans 1770'

KC 2085'

8" @ 2130'

Drlg 2435'

12/17

Miss 2536'

8" @ 2536'

TD 2570-1000' oil

1947

1/2

Miss 2536'

7" @ 2536'

TD 2570'

50 qts 2538-2560

Pump 45 POT

38 Grav.

COMPLETED

Map No. 14 Sec. 17 Twp. 25 R. 5E

Well No. 6 Robinson

Wilson Oil Company

FIRST REPORT

Contractor

NW NE SW

SECTION PLAT

330 Ft. from N. Line

 Ft. from S. Line

990 Ft. from E. Line

 Ft. from W. Line

	o		

Butler County

Location

Rig up

Drilling and Remarks:

Rig

RECORD

Cased in., ft.

Sand

Gas

Oil

Total Depth

PRODUCTION

1st 24 hrs. Nat.

1st 24 hrs. after shot

Gas Cu. Ft.

Dry Hole

Abandoned

Date

NOV 13 1946

19

S. J. LEWIS

Scout

Map No. 1 C Sec. 17 Twp. 25 R. 5EWell No. 7 RobinsonWilson Oil Company**CORRECTION**


Contractor

NW NE SW

SECTION PLAT

330 Ft. from N. Line Ft. from S. Line990 Ft. from E. Line Ft. from W. Line

Butler County

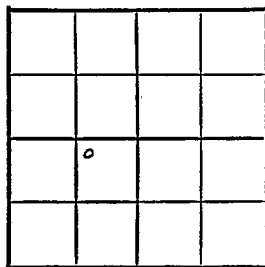Location Rig up

Drilling and Remarks:

Reported as
#6 Robinson

RECORD

Cased in., ft.Sand Gas Oil Total Depth

PRODUCTION

1st 24 hrs. Nat. 1st 24-hrs. after shot Gas Cu. Ft.Dry Hole Abandoned

Date

DEC 4 1946 19S. J. LEWIS

Scout

Kansas KANSAS

Map No. 10 Sec. 17 Twp. 25 R. 5EWell No. 7 RobinsonWilson Oil

Company

COMPLETED

Contractor


NW NE SW

E 11894

SECTION PLAT

330 Ft. from N. Line Ft. from S. Line990 Ft. from E. Line Ft. from W. Line

Butler County

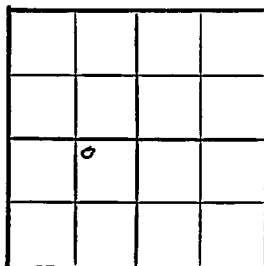Location Rig up

Drilling and Remarks:

Miss 2536:
7' @ 2536
529 to 2538-60
Pump 45 RY.

382 RY

RECORD

Cased in., ft.Sand Gas Oil Total Depth 2570

PRODUCTION

1st 24 hrs. Nat. 1st 24 hrs. after shot Gas Cu. Ft.Dry Hole Abandoned

Date

JAN 2 1947 19

S. J. LEWIS

Scout