


Section 17 Township 25 Range 5E

Well No. 9 Robinson

Company Dustin & Darling

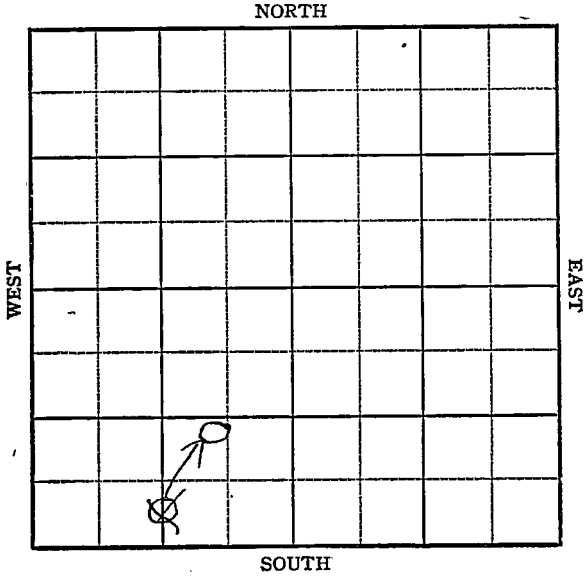

Sec. 17 Twp. 25 R. 5-E

Well No. #9 Robinson Farm

Dustin & Darling Company

Miscellaneous

Ft. from N. Line

890'  
~~330~~


Ft. from S. Line

660'  
~~1320~~

Ft. from E. Line

Ft. from W. Line

~~C S L SW~~  
C N L SE SW

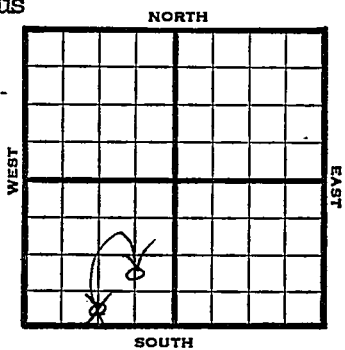

1948 Elev. 1389' REPORT

- 8/4 Machine
- 8/11 Drlg 90'
- 8/18 Drlg 910'
- 8/25 12" @ 865'
- 10" @ 1685'
- Lansing 1785'
- Drlg 1850'
- 9/1 KC 2060'
- 8" @ 2150'
- Drlg. 2385'
- 9/8 Chat 2500'
- 5" @ 2501'
- TD 2720' HFW

**ABANDONED**





Butler County Kansas State

Map No. 14 Sec. 17 Twp. 25 R. 5E

Well No. 9 Robinson

Dustin & Darling Company

ABANDONED

Contractor

C N L SE SW

E. 1389  
SECTION PLAT

Ft. from N. Line

990 Ft. from S. Line

660 Ft. from E. Line

Ft. from W. Line


Miscellaneous

Remarks:

Chat 25-00

5" @ 25-01

Y 5 2720 X F W.

Date SEP 8 1948

Scout S. J. LEWIS