

KANSAS


Butler

Section 17 Township 25 Range 5E

Well No. 10 Wilson Robinson

Company Harry Wilson

Misc.
NORTH

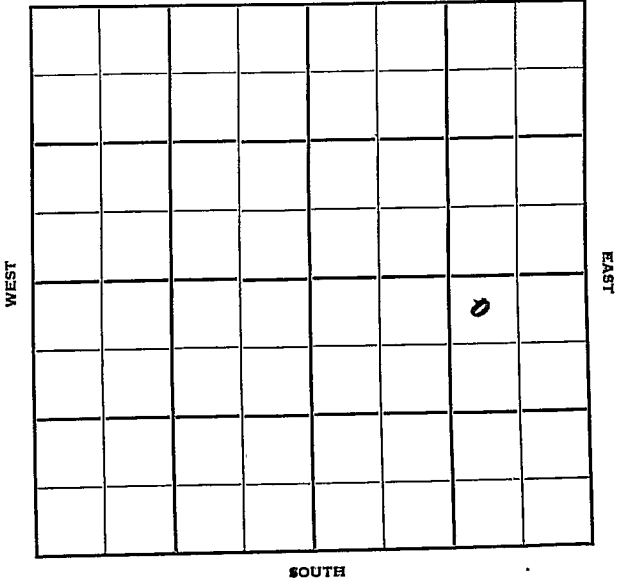

Butler **KANSAS**

Sec. 17 Twp. 25 R. 5E

Well No. #10 Wilson Robinson Farm

Harry Wilson Company


Miscellaneous (Wixson, Cont^{NORTH})

330' Ft. from N. Line

_____ Ft. from S. Line

990' Ft. from E. Line

_____ Ft. from W. Line

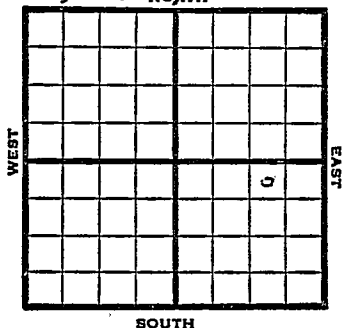

NW NE SE

1949 Elev. 1378' REPORT

9/21 Machine

9/28 15" @ 165'

Drlg 435'

10/5 12" @ 875'

Drlg 1130'

10/12 Drlg 2255'

10/19 KC 2040'

8" @ 2050'

Mississippi 2466'

TD 2478'

4" @ 2478'

10/26 Miss 2466'

4" @ 2478'

Pump 20 oil Pot.

Gr. 38°

TD 2526'

COMPLETED

Map No. _____ Sec. 17 Twp. 25 R. 5E

Well No. 10 Wilson

Harry Wilson Company

Wixson Contractor

NW NE SE

FIRST REPORT
SECTION PLAT

330 Ft. from N. Line

_____ Ft. from S. Line

990 Ft. from E. Line

_____ Ft. from W. Line

			Δ

Butler County

RECORD

Location _____

Cased _____ in., _____ ft.

Rig up _____

Sand _____

Drilling and Remarks: _____

Gas _____

Oil _____

Total Depth _____

Machine _____

PRODUCTION

1st 24 hrs. Nat. _____

1st 24 hrs. after shot _____

Gas _____ Cu. Ft.

Dry Hole _____

Abandoned _____

Date

SEP 21 1949 19

S. J. LEWIS Scout

Map No. _____ Sec. 17 Twp. 25 R. 5E

Well No. 10 Robinson

Harry Wilson Company

CORRECTION Contractor

NW NE SE

SECTION PLAT

330 Ft. from N. Line

_____ Ft. from S. Line

990 Ft. from E. Line

_____ Ft. from W. Line

			o

Butler County

RECORD

Location _____

Cased _____ in., _____ ft.

Rig up _____

Sand _____

Drilling and Remarks:

Gas _____

Oil _____

Total Depth _____

Reported as

#10 Wilson

PRODUCTION

1st 24 hrs. Nat. _____

1st 24 hrs. after shot _____

Gas _____ Cu. Ft.

Dry Hole _____

Abandoned _____

Date

SEP 28 1949

19

S. J. LEWIS

Scout

Kansas

Map No. _____ Sec. 17 Twp. 25 R. 5E

Well No. 10 Robinson

Harry Wilson Company

COMPLETE

Contractor

NW NE SE

E1.1378
SECTION PLAT

330 Ft. from N. Line

_____ Ft. from S. Line

990 Ft. from E. Line

_____ Ft. from W. Line

			o

Butler County

Location _____

Rig up _____

Drilling and Remarks:

*Wier 2466**# 162478**Run 20 oil**9896*

RECORD

Cased _____ in., _____ ft.

Sand _____

Gas _____

Oil _____

Total Depth *21526*

PRODUCTION

1st 24-hrs. Nat. _____

1st 24-hrs. after shot _____

Gas _____ Cu. Ft.

Dry Hole _____

Abandoned _____

Date

OCT 26 1949

19

S. J. LEWIS Scout