


Section 17 Township 25 Range 5E

Well No. #11 Robinson

Company Wilson Prod.

NORTH

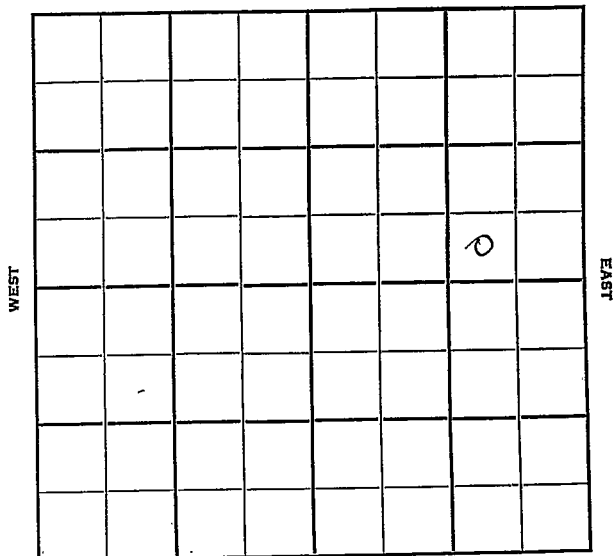

SOUTH

Sec. 17 Twp. 25 R. 5E ✓

Well No. #11 Robinson Farm

Wilson Prod. Company


Contractor

_____ Ft. from N. Line

330' Ft. from S. Line

990' Ft. from E. Line

_____ Ft. from W. Line

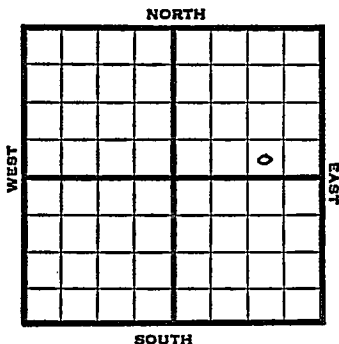

SW SE NE

1951 Elev. 1373' REPORT

6/13 Drilling
Spud 6-11-51

7/25 Spud 6-11-51
Oil Well TD 2516
15" @ 170 13" @ 270
10" @ 1650 7" @ 2480
Miss 2493 TD 2516
Comp. 25 bopd

COMPLETED

County **Butler** State **Kansas**

Sec. **17** (Blk. Twp.) **25** (Sur. Rge.) **5E** Map No.

Operator **Wilson Prod.**

Well No. **11** Farm **Robinson**

Elev. Location **SW SE NE**

330 Ft. From **S** Line **NE**

990 Ft. From **E** Line Quarter

Ist. Report **JUN 13 1951**

Completion

Remarks

Spudding Date **6-11-51**

Drlg. Data

Drilling

County Butler State Kansas

Sec. 17 (Blk. 25) (Sur. 5E) (Rge.) Map No.

Operator Wilson Prod.

Well No. 11 Farm Robinson

Elev. 1373 Location SW SE NE

COMPLETE

0

330 Ft. From S Line NE
990 Ft. From E Line Quarter

Ist. Report

Completion JUL 25 1951

Remarks

Spudding Date 6-11-51

Drlg. Data Oil well TD 2516

15" @ 170 13" @ 270 10" @ 1650

7" @ 2480 Miss. 2493 TD 2516

Comp. 25 b opd