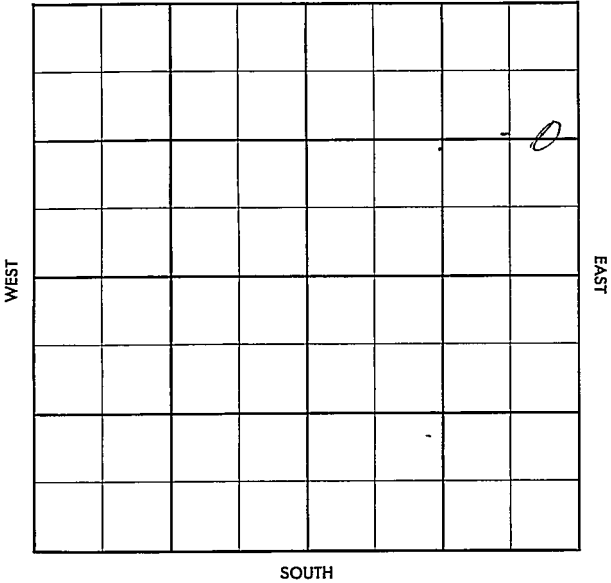


Barton

KANSAS

SECTION 29 TOWNSHIP 17 RANGE 14WWELL NO. #3 DirreenCOMPANY Stickle Drlg.NORTH C E $\frac{1}{2}$ E $\frac{1}{2}$ NE

Date Comm. _____

Location _____

~~13~~

County Barton Elev. 1861
 Sec. 29 Twp. 17 Rge. 11W
 Company Stickley Drig.
 Farm Name Dirreen No. 3

TOPS	DEPTH	LOG	DATUM	Loc. in Sec.
Anb.	835			C E $\frac{1}{2}$ E $\frac{1}{2}$ NE
TP.	3032			
H.				
Tr.				
Dg.	3098			
BL.	3108			
L.				Geol.
K.C.				Contr.
BKC.				Co. tools
Ce.	3324			Pool
C.				Carroll
M.				
M.				
K.				
Mz.				
Me.				
V.				
S.				
S.				
A.	3366			
R.				
PE.				ABANDONED
G.				
TD.	3420			

Date Comm.

Location FEB 6 '57 2-1-57 8578

847 @ 2740 FEB 12 '57

DST 3367-73 4 1/2 hr run 20'

@ Md BHP no recorded DST

3368-88 1 hr 13' @ Md BHP

135/30

D & A