
Barton KANSAS

29 17S 14W

SECTION TOWNSHIP RANGE

WELL NO. #4 Dirreen

COMPANY Stickle Drlg.

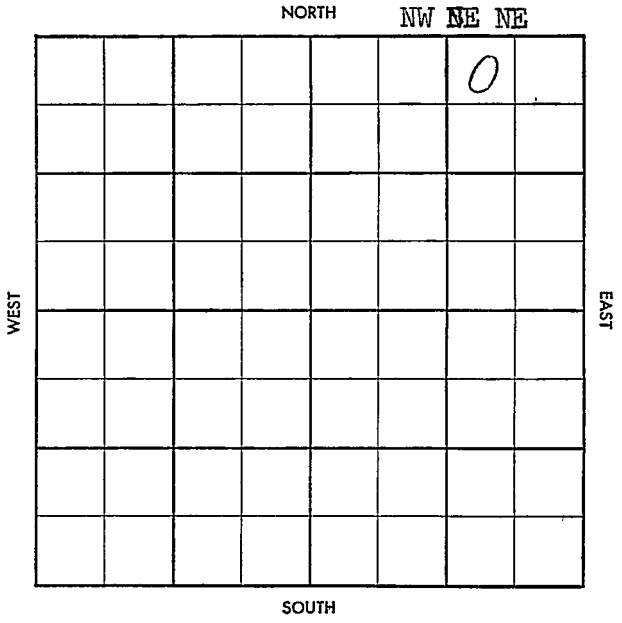

1

FORM 504-3 SUNRAY

S-513-A

1868RB

CO. Barton ELEV. 1865DF

SEC. 29 TWP. 17 RGE. 14W

COMPANY Stickle Drlg. NO. 4

FARM Dirreen

LOC. NW NE NE

Anh 835	
Heeb 3031	
Br Lm3095	

GEOL.

CONTR. Co. Tools rig #4

POOL Carroll

SPUD 11/14/57

8" @ 844. circ. @ 3110.

CO. LSE. NO. SEC. TWP. RGE.

S-513-A

CO. Barton ELEV 1868RB 1865DF

SEC. 29 TWP. 17 RGE. 14W

COMPANY Stickle Drlg. NO. 4

DEC 26 57

COMPLETE

FARM Dirreen

LOC. NW NW NE

Ann 835	
Heeb 3031	
Br Lm3095	

GEOL.

CONTR. Co. Tools #4

POOL Carroll

SPUD 11/1/57

8" C.L. circ.

Log Tops HB 834

Hb 3031 L 3106

Bk 3095 C 3319 Ar 3334

Sand 5 LTD 3365

RTD 3369 5½ 3364 DST

3098-3132 60" 45' WCM

VSSO BHP 600/30 DEC 4 57

DEC 11 57 C03360 FJ 10-12BF

Ph NT 24/3348-54

½ 12130 ph + TW NT

16/3338-42 NT + SW pkr

DEC 18 57 DEC 26 57 25 BOPD

+ 180 TW

Ark 3335-54