

Butler


Antlers

SECTION 17 TOWNSHIP 25 RANGE 5E

WELL NO. #15 Robison (Robinson)

COMPANY Wilson Oil

NORTH

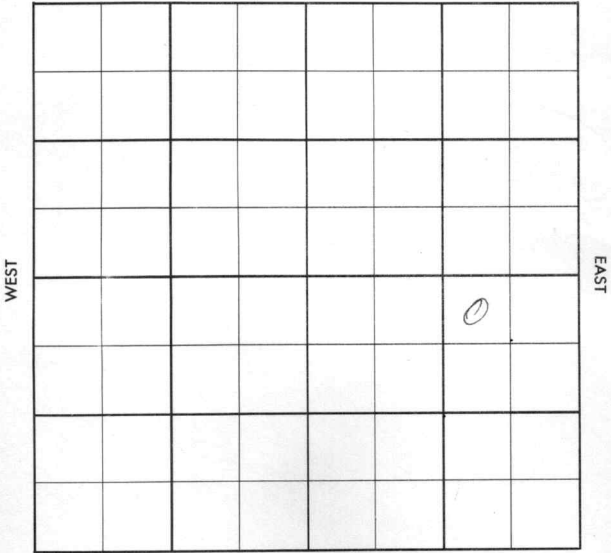

SOUTH

County Butler Elev. 1366  
 Sec. 17 Twp. 25 Rge. 5E  
 Company Wilson Oil  
 Farm Name Robison No. 15

TOPS	DEPTH	LOG	DATUM	Loc. in Sec.
Anh.				NW NE SE
TP.				2250' SL
H.				1250' EL
Tr.				
Dg.				
BL.				
L.				Geol.
K.C.				Contr.
B.K.C.				Baker
Ce.				
C.				Pool
M.				ElDorado
M.				
K.				
Mz.				
Mq.				
V.				
S.				
S.				
A.				
R.				
PE.				
G.				
T.D.				

FIRST REPORT  
 JAN 3 '37

Date Comm. 12-28-56

drlg. 150

Co.  
 Sec.  
 No.  
 Sec.  
 T.  
 R.

Co.

County Butler Elev. 1366  
 Sec. 17 Twp. 25 Rge. 5E  
 Company Wilson Oil  
 Farm Name Robison No. 15

TOPS	DEPTH	LOG	DATUM
Anh.			
TP.			
H.			
Tr.			
Dg.			
BL.			
L.			
K.C.			
<del>100'</del> <u>5d</u>	<u>696</u>		
Ce.			
C.			
M.			
M.			
K.			
Mz.			
Ma.			
V.			
S.			
S.			
A.			
R.			
PE.			
G.			
T.D.	<u>706</u>		

Loc. in Sec. NW NE SE  
2250' SL  
1250' EL

Geol. \_\_\_\_\_  
 Contr. Baker

Pool ElDorado

**COMPLETE**  
 10  
 JAN 16 '57

Use.

No.

Sec.

T.

R.

Date Comm. 12-28-56  
drlg. 150 JAN 9 '57 10 400'  
JAN 15 '57 7" @ 697 1.8 Bopd.  
w.o. water flood