

Section 28 Township 17 Range 14W

Well No. #4 Mieter "A" (Meitner)

Company Bridgeport CRA

Carroll Port

NORTH

WEST

EAST

0							

SOUTH

4

O. W. P. E. Barton
KANSAS

Sec. 28 Twp. 17 R. 14W

Well No. #4 Mieter "A" Farm

~~Bridgeport~~ CRA Company

Carroll Pool


990' Ft. from N. Line

Ft. from S. Line

Ft. from E. Line

330' Ft. from W. Line

SW NW NW

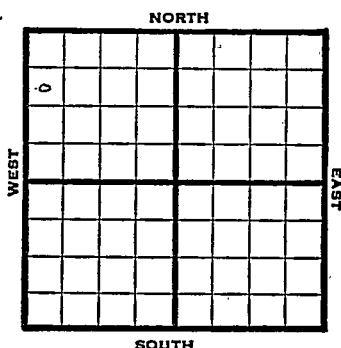

1948	Elev. 1861' REPORT
2/25	Location
3/3	"
3/10	Drlg. 350'
3/17	8" @ 865' Drlg. 1780'
3/24	Lansing 3084' Arbuckle 3346' TD 3350' 5" @ 3347' RUST
3/31	TD 3364 swb 61 bbls oil in 5 hrs.
4/7	"
4/14	"
4/21	"
4/28	Pump 68 bbls. oil in 10½ hrs.
5/5	1000 acid.
5/12	Pump 14 bbls oil PH

OVER

1948

5/19 Arbuckle 3346'
5" @ 3347'
Acid 1000
Pump 438 oil Pot.
Gr. 36°
TD 3364'

COMPLETED

1956

O. W. P. B

2-22 OTD 3364'
5" @ 3349
PB 3290
16/3094-98
B/9 go 3 hrs., 1000 A
S/ 13.30 boph, 2~~3~~ hrs.
PB 3284
POP
KC 3084
A 3348

Map No. _____ Sec. 28 Twp. 17 R. 14W

Well No. 4 Mieter "A"

Bridgeport

Company

FIRST REPORT

Contractor

SW NW NW

SECTION PLAT

o			

990 Ft. from N. Line

_____ Ft. from S. Line

_____ Ft. from E. Line

330 Ft. from W. Line

Barton County

Location X

Rig up _____

Drilling and Remarks:

RECORD

Cased _____ in., _____ ft.

Sand _____

Gas _____

Oil _____

Total Depth _____

PRODUCTION

1st 24 hrs. Nat. _____

1st 24 hrs. after shot _____

Gas _____ Cu. Ft.

Dry Hole _____

Abandoned _____

Date

FEB 25 1948 19 S. J. LEWIS Scout

Map No. 73 Sec. 28 Twp. 17 R. 14W

Well No. 4 Mieter "A"

Bridgeport

Company

COMPLETE

Contractor

SW NW NW

E 1/8 61
SECTION PLAT

990 Ft. from N. Line

 Ft. from S. Line

 Ft. from E. Line

330 Ft. from W. Line

4			

Barton County

Location

Rig up

Drilling and Remarks:

CE 8346
5" CE 8347
1000 acid
Pump 488 oil P. & T.
26° Cu

RECORD

Cased in., ft.

Sand

Gas

Oil ✓

Total Depth 3364

PRODUCTION

1st 24 hrs. Nat.

1st 24 hrs. after shot

Gas Cu. Ft.

Dry Hole

Abandoned

Date

MAY 19 1948

19

S. J. LEWIS

Scout

FORM 513 REV. SUNRAY

O. W. P. B.

OWPB

County Barton Elev. 1861
 Sec. 28 Twp. 17 Rge. 14W
 Company G R A
 Farm Name Meitner "A" No. 4

TOPS	DEPTH	LOG	DATUM	Loc. in Sec.
Anh.				SW NW NW
Tr.				
H.				
Tr.				
Dg.				
Bl.				
L.				
K.C.	306h			Geol.
B.K.C.				Contr.
Ce.				
C.				
M.				
M.				Pool
K.				Carroll
Mz.				
Mq.				
V.				
S.				
S.	334h			
A				
R.				
Pe.				
G.				
T.D.	336h			

Date Comm.

5ⁿ @ 3349 PB 3290 16/ 3094-98

B/ 9 go 3 hr. 1000 A S/ 13.30 boph

23 hr. PB 3284 P O P

County Barton Elevation 1861
 Sec. 28 Twp. 17 Rge. 14W
 Company C R A
 Farm Name Meitner "A" No. 1

TOPS	DEPTH	LOG	DATUM	Loc. in Sec.
Ant.				SW NW NW
Tp.				
H.				
Tr.				
Dg.				
Bl.				
L.				
K.C.	3004		1222	Geol.
B.K.C.				Contr.
Ce.				
C.				
M.				
M.				Pool
K.				Carroll
Mr.				
Ma.				
V.				
S.				
S.	3348		1287	
A.				
R.				
PC.				
G.				
TA.	3364			

FEB 29 1956

Date Comm.

5th @ 3349 PB 3290 16/ 3094-98

B/ 9 go 3 hr. 1000 A S/ 13.30 boph

23 hr. PB 3284 P O P

FEB 29⁵⁶ P 48 B O n o / w 24

hwa.