

Barton


KANSAS

FORM 51

Section 29 Township 17 Range 14W

Well No. #1 Dirreen

Company Harwood & Stickle

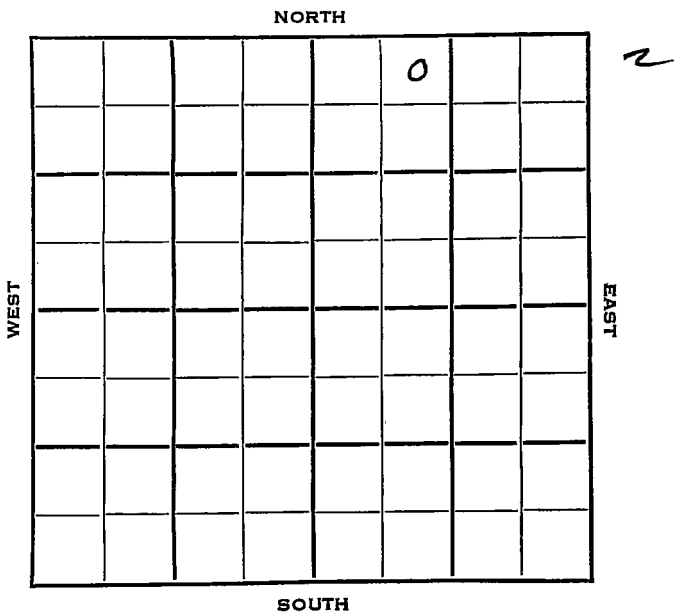

Barton

KANSAS

SEC. 29	TWP. 17	R. 11W
---------	---------	--------

WELL NO. #1 Dirreen FARM

COMPANY Harwood & Stickle

CONTRACTOR Stickle Drlg.

Carroll Pool

330 Ft. from N. Line

Ft. from S. Line

Ft. from E. Line

990 Ft. from W. Line

NE NW NE

	ELEVATION	REPORT
1953	1868'	
9/23		Spud 9-15-53 8" @ 850' Drlg 2940'
9/30		Anhy 840, Heeb 3037, Br. L. 3099' DST 3105-18' 1 hr, 10' M Lans 3109'
10/7		Arb. 3346' RTD 3353' 5" @ 3347
10/21		NR
11/4		Spud 9-15-53 Oil well TD 3374 8" @ 850 Anhy 840 Heeb 3037 Br. lime 3099' DST 3105-18 open 1 hr. rec 10' mud Lans. 3109 Arb. 3346 TD 3357 5" @ 3357 DST 3117-26 open 1 hr. rec 15' mud Off DST 3138-56 open 1 hr. rec 10' mud Off DD 3366 1 BOPH 50-mud acid 500 A DD 3374 FU 110' oil 4 hr. 3 BOPH P/1 1/2 BOPH Comp. 35 BOPD 10% wtr.
COMPLETED		

County Barton State Kansas

Sec. 29 (Blk. Twp.) 17 (Sur. Rge.) 14W Map No.

Operator Harwood & Stickle

Well No. 1 Farm Dirreen

Elev. 1868 Location NE NW NE

330 Ft. From N Line NE

990 Ft. From W Line Quarter

1st. Report SEP 23 1953

Completion _____

Remarks _____

Stickle Drlg. - Contr.

Spudding Date 9-15-53

Drlg. Data Carroll Pool

8" @ 850 drlg. 2940

