
FORM 51 25M 3-49 PETROL

KANSAS Ness

Section 33 Township 17 Range 25-W

Well No. #9 Olson

Company Magnolia

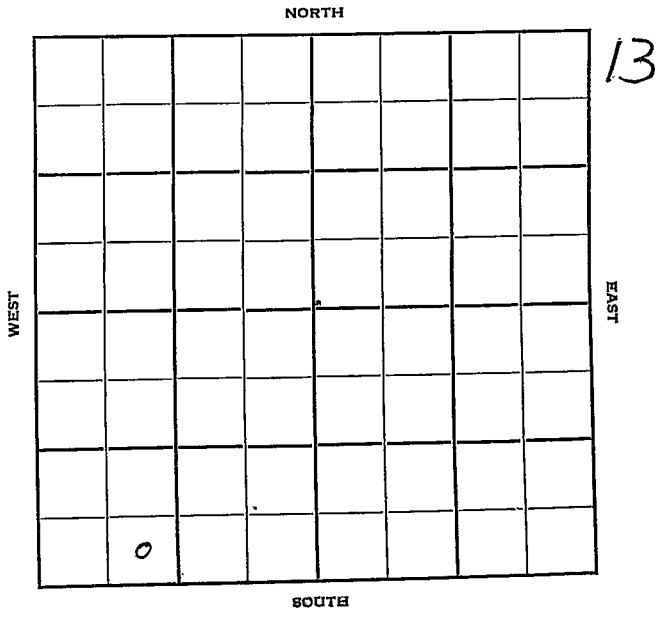

FORM 252-B
10M 9-49 PETROL

Ness KANSAS

Sec. 33 Twp. 17 R. 25W

Well No. #9 Olson Farm

Magnolia Company

Barnett Drlg. Contractor

Aldrich Pool


Ft. from N. Line

330' Ft. from S. Line

Ft. from E. Line

990' Ft. from W. Line

SE SW SW

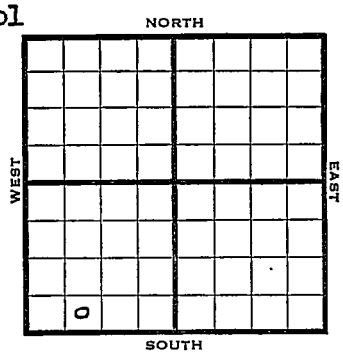

1950	Elev 2372 REPORT
7/5	Spd 6-30-50 10" @ 652 WOC
8/2	19" @ 652 Miss 4256 Cored 4257-63, rec 3½' sta lime 7" @ 4263 TD 4273 S/4½ boph 1000A TD 4280 Comp 196 bopd Completed
	COMPLETED

Form 26 200 Bks. 11-49 Petrol

Aldrich Pool

Kansas

Map No. _____ Sec. 33 Twp. 17 R. 25W


Well No. 9 Olson

Magnolia Company

Barnett Drlg. Contractor

SE SW SW

SECTION PLAT

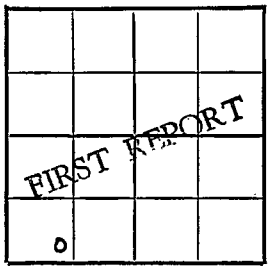

_____ Ft. from N. Line

330 Ft. from S. Line

_____ Ft. from E. Line

990 Ft. from W. Line

Ness County

Location _____

Rig up _____

Drilling and Remarks:

Spud 6-30-50

10" @ 652

WOC

RECORD

Cased _____ in., _____ ft.

Sand _____

Gas _____

Oil _____

Total Depth _____

PRODUCTION

1st 24 hrs. Nat. _____

1st 24 hrs. after shot _____

Gas _____ Cu. Ft.

Dry Hole _____

Abandoned _____

Date

JUL 5 1950 19

J. E. TYRA Scout

FORM 275 FOR SALE BY KANSAS BLUE PRINT CO.


County Ness State Kansas

Sec. 33 (Blk. Twp.) 17 (Sur. Rge.) 25W Map No.

Operator Magnolia

Well No. 9 Farm Olson

Elev. 2372 Location SE SW SW

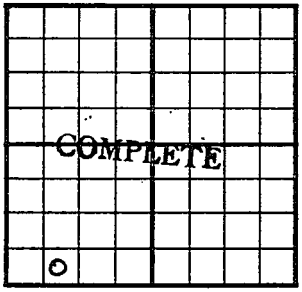

330 Ft. From S Line SW

990 Ft. From W Line Quarter

1st. Report

Completion AUG 2 1950

Remarks

Spudding Date 6-30-50

Drlg. Data Aldrich Pool

10" @ 652 Miss. 4256 Cored 4257-63

Rec. 3½' sat. lime 7" @ 4263 TD 4273

S/ 4½ boph 1000 A TD 4280

Comp. 196 bopd

J. E. TYRA