

KANSAS


FORM 51 5M 1-42 PETROL

Butler

Section 17 Township 25 Range 5-E

Well No. #26 Robinson

Company Texas

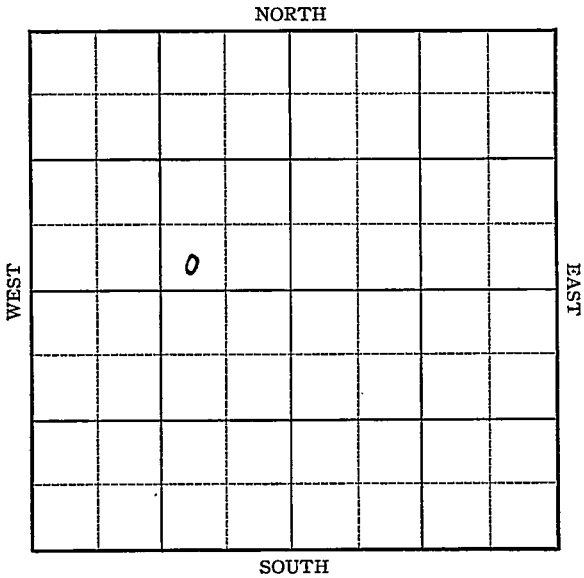


Sec. 17 Twp. 25 R. 5-E

Well No. #26 Robinson Farm

Texas Company

NORTH

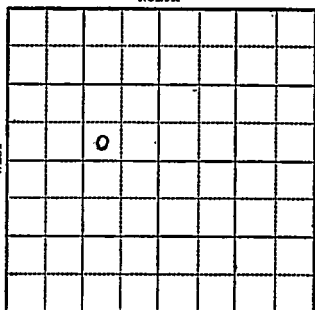

_____ Ft. from N. Line

330 Ft. from S. Line

990 Ft. from E. Line

_____ Ft. from W. Line

SOUTH

1943

Law. 1288 R E P O R T

8/11

Machine

8/18

"

8 /25

15" @ 238'

Drlg. 680'

9/1

Drlg. 1115

12 @ 976'

9/8

10" @ 1667'

Drlg. 1945'

9/15

Drlg. 2480

9/22

Miss 2653

7" @ 2546

T.D. 2593

swab & 40 oil in 10 hrs

9/29

Miss 2563

7" @ 2564

Pump 77 Pot.

Gravity 36

T.D. 2593'

COMPLETED

KANSAS
 Map No. 4 Sec. 17 Twp. 25 R. 5E

Well No. 26 Robinson

Texas Company

FIRST REPORT Contractor

SW SE NW

SECTION PLAT

_____ Ft. from N. Line

330 Ft. from S. Line

990 Ft. from E. Line

_____ Ft. from W. Line

	o		

WILDCA T

Location _____

Rig up _____

Drilling and Remarks: _____

Machine _____

RECORD

Cased _____ in., _____ ft.

Sand _____

Gas _____

Oil _____

Total Depth _____

PRODUCTION

1st 24 hrs. Nat. _____

1st 24 hrs. after shot _____

Gas _____ Cu. Ft.

Dry Hole _____

Abandoned _____

Date

AUG 1 1 1943 19

S. J. LEWIS

Scout

KANSAS

Map No. 72 Sec. 17 Twp. 25 R. 5E

Well No. 26 Robinson

Texas Company

COMPLETED Contractor

SW SE NW

SECTION PLAT

_____ Ft. from N. Line

330 Ft. from S. Line

990 Ft. from E. Line

_____ Ft. from W. Line

	0		

Wildcat

Location _____

Rig up _____

Drilling and Remarks:

Start 2563
7" @ 2564
Pump 77.25

36 1/2

RECORD

Cased _____ in., _____ ft.

Sand _____

Gas _____

Oil _____

Total Depth 2572

PRODUCTION

1st 24 hrs. Nat. _____

1st 24 hrs. after shot _____

Gas _____ Cu. Ft.

Dry Hole 11

Abandoned _____

Date

SEP 29 1943 19

S. J. LEWIS Scout