

KANSAS


FORM 51 5M 1-42 PETROL

Ness

Section 27 Township 17 Range 25-W

Well No. #1 Reed "A"

Company Magnolia

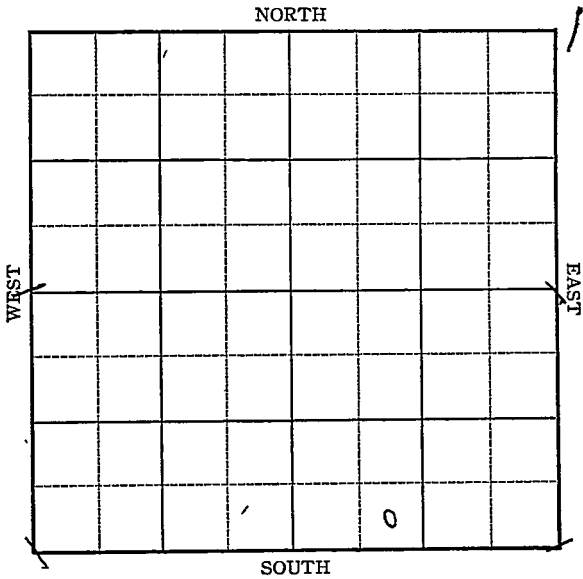

KANSAS

. Ness

Sec. 27 Twp. 17 R. 25 ^W

Well No. #1 Reed "A" Farm

Magnolia Company.


 Ft. from N. Line

330 Ft. from S. Line

 Ft. from E. Line

990 Ft. from W. Line

Elev. 2428

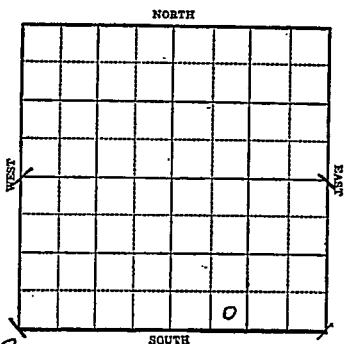

1943

R E P O R T

7/14

10" @ 378'

Waiting on cement

7/21

Drlg. 2680'

7/28

Trans (3802?) ~

T.D. 4015'

8/4

Miss (3306) ~ ~

Drlg. 4520

No shows.

8/11

Drlg. 4665'

8/18

Kind 4757

Misener 4762

Viola 4774

No shows

T.D. 4790'


ABANDONED

KANSAS NessMap No. 77 Sec. 27 Twp. 17 R. 25WWell No. 1 Reed "A"Magnolia-

Company

FIRST REPORT

Contractor

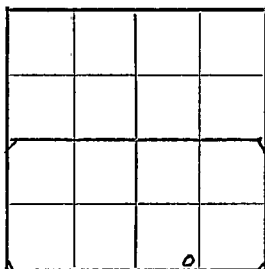SE SW SE**SECTION PLAT** Ft. from N. Line330 Ft. from S. Line Ft. from E. Line990 Ft. from W. Line**No Pool Name**Location Rig up

Drilling and Remarks:

10"-378'**Waiting on
cement****RECORD**Cased in., ft.Sand Gas Oil Total Depth **PRODUCTION**1st 24 hrs. Nat. 1st 24 hrs. after shot Gas Cu. Ft.Dry Hole Abandoned

Date

JUL 14 1943 19S. I. LEWIS Scout

KANSAS

Ness

Map No. 77 Sec. 27 Twp. 17 R. 25WWell No. 1 Reed "A"Magnolia

Company

ABANDONED

Contractor

SECTION PLAT

SE SW SE

Ft. from N. Line

330 Ft. from S. Line

Ft. from E. Line

990 Ft. from W. Line

ALDRICH POOL

Location _____

Rig up _____

Drilling and Remarks:

*Kind 4757**Alvener 4762**Vidra 4774**Nashvire*

RECORD

Cased _____ in., _____ ft.

Sand _____

Gas _____

Oil _____

Total Depth 4790

PRODUCTION

1st 24 hrs. Nat. _____

1st 24 hrs. after shot _____

Gas _____ Cu. Ft.

Dry Hole _____

Abandoned _____

Date

AUG 1 8 1943 19S. J. LEWIS Scout