


Section 33 Township 17 Range 25W

Well No. #5 B. Olson

Company Magnolia

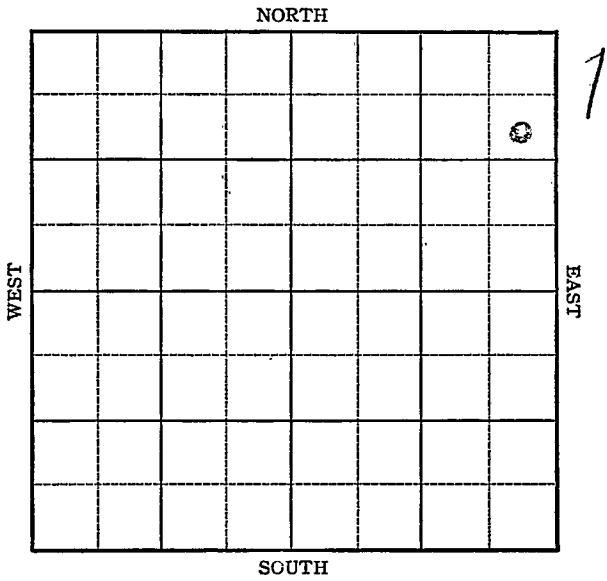

Sec. 33 Twp. 17 R. 25W

Well No. #5 B. Olson Farm

Magnolia Company


Aldrich

990 Ft. from N. Line

_____ Ft. from S. Line

330 Ft. from E. Line

_____ Ft. from W. Line

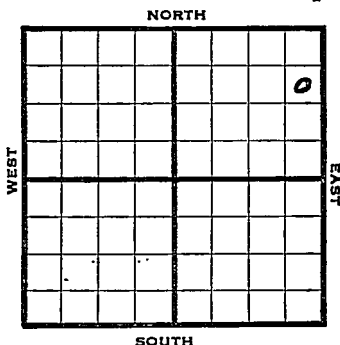

SE NE NE

1945

R E P O R T

2/28

R U R

3/7

8" @ 346
Drlg 1875

3/14

Drlg 3400

3/23

Cong 4270
Miss 4282-4299
TD 4299

3/29

5" @ 4297 RUST
TD 4301 250 acid.
Pump 17 oil PH 6 hrs.

4/4

Miss 4282
5" @ 4297
250 acid.
TD 4301
Pump 803 pot.
Grav. 37.5

COMPLETED

Pool Name AldrichMap No. 77 Sec. 33 Twp. 17 R. 25WWell No. 5 B OlsonMagnolia CompanyFIRST REPORT Contractor

SE NE NE

SECTION PLAT

900 Ft. from N. Line Ft. from S. Line350 Ft. from E. Line Ft. from W. Line

			o

NessLocation Rig up

Drilling and Remarks:

RUR

RECORD

Cased in., ft.Sand Gas Oil Total Depth

PRODUCTION

1st 24 hrs. Nat. 1st 24 hrs. after shot Gas Cu. Ft.Dry Hole Abandoned

Date

FEB 28 1945 19

S. J. LEWIS Scout

