


Section 10 Township 17 Range 26W

Well No. #1 T. Dumlér

Company R.H. Siegfried-Rooney & Thomas

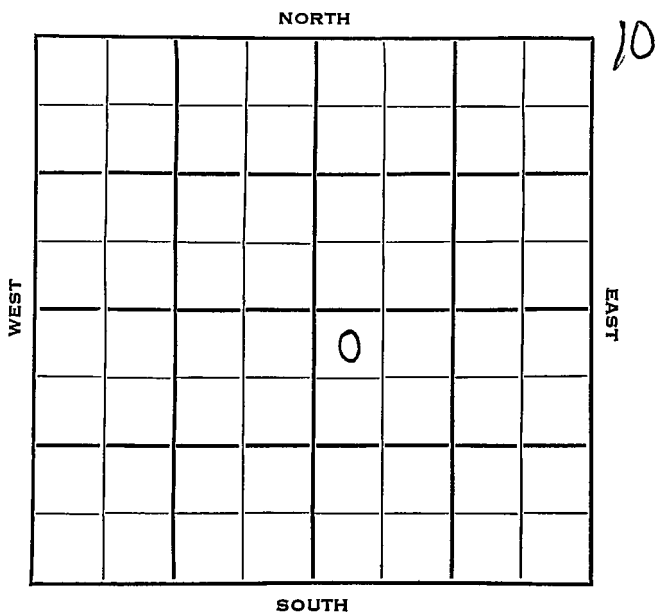

Ness

KANSAS

SEC.	TWP.	R.
10	17	26 W ✓

WELL NO.

# 1 T. Dumlér

FARM

COMPANY

R. H. Siegfried-Rooney &amp; Thomas

CONTRACTOR

Schaffer


Wildcat

330 \_\_\_\_\_ Ft. from N. Line

\_\_\_\_\_ Ft. from S. Line

\_\_\_\_\_ Ft. from E. Line

330 \_\_\_\_\_ Ft. from W. Line

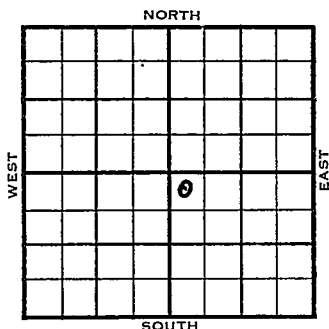

NW NW SE

Carter - Ac. &amp; DHM

	ELEVATION	REPORT
1953	2581'	
10/7	Spud 10-3-53	Surface pipe set.
10/14	8" @ 282 w/200	Drlg. 3367'
10/21	Heeb 3873 Dodge 3889 KC 3914 B KC 4291	DST 4446-66, 1 hr, 10' M Sd 4545' Cong 4553' DST 4541-56, 1 hr, 20' M DST 4558-77, 1 hr, 110' SW Drlg. 4577'
10/28	Spud 10-3-53 D & A TD 4659' 8" @ 282 Heeb 3873 Dodge 3889 KC 3914 B KC 4291	DST 4446-66 open 1 hr rec 10' mud # Sd. 4545 Cong. 4553' DST 4541-56 open 1 hr rec 20' mud DST 4558-77 open 1 hr rec 110' SW Cong 4551 Miss 4556 TD 4659' D & A

**ABANDONED**

County Ness State Kansas  
 Sec. 10 (Blk. Twp.) 17 (Sur. Rge.) 26W Map No.  
 Operator R.H. Siegfried-Rooney & Thomas  
 Well No. 1 Farm T. Dangler  
 Elev. \_\_\_\_\_ Location NW NW SE


330 Ft. From N Line SE330 Ft. From W Line Quarter1st. Report OCT 7 1953

Completion \_\_\_\_\_

Remarks Carter - Ac & DHMSchaffer - Contr.Spudding Date 10-3-53

Drlg. Data \_\_\_\_\_

Wildcatsurface pipe set

