


Barton

KANSAS

SECTION 17 TOWNSHIP 16S RANGE 11W

WELL NO. #1 Ney

COMPANY Wilkinson Drlg.

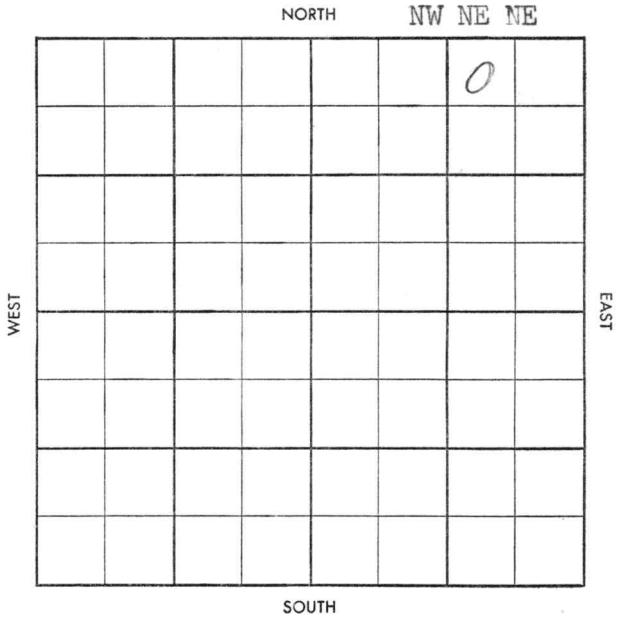

✓ 13

S-513-B

County Barton Elev. \_\_\_\_\_  
 Sec. 17 Twp. 16 Rge. 11W  
 Company Wilkinson Drlg.  
 Farm Name Ney No. 1

TOPS	DEPTH	LOG	DATUM	Loc. in Sec.
Anh.				NW NE NE
Tp.				
H.				
Tr.				
Dg.				
B. L.				
L.				
K.C.				Geol.
B.K.C.				Contr.
Ce.				Co. Tools
C.				
M.				Pool
M.				Kraft-Prusa
K.				
Mz.				
Mq.				
V.				
S.				
S.				
A.				
R.				
Pf.				
G.				
T.D.				



Date Comm. 1/20/58, 8" @ 429 w/225, WOG

Co.  
Lse.  
No.  
Sec.  
T.  
R.

S-513-B

County Barton Elev. 1811 DE 1817 BE  
 Sec. 17 Twp. 16 Rge. 11W  
 Company Wilkinson Drlg.  
 Farm Name Ney No. 1

TOPS	DEPTH	LOG	DATUM	Loc. in Sec.
Anh.				NW NE NE
Tp.				
H.	<u>2847</u>			
Tr.				
Dg.	<u>2875</u>			
B.L.	<u>2937</u>			
L.	<u>2953</u>			
K.C.				Geol.
B.K.C.				Contr.
Ce.				Co. Tools
C.	<u>3240</u>			Pool
M.				Kraft-Prusa
M.				
K.				
Mz.				
Mq.				
V.				
S.				
S.				
A.	<u>3299</u>			
R.				
Pf.				
G.				
T.D.	<u>3313</u>			

Date Comm. 1/20/58, 8" @ 429 w/225, WOC  
JAN 29 '58 DST 2956 - 3026 60" 9 1/4"  
2-40 mcl/12" + 875' g.c.MW  
FP 280 - 370 BHP 605/22" DST  
3026-42 60" 120' H GEM SSO 310W  
SSO FP 135-250 BHP 775/20"  
no log

D&amp;A