


Section 17 Township 25 Range 5E

Well No. #31 Robinson

Company Texas

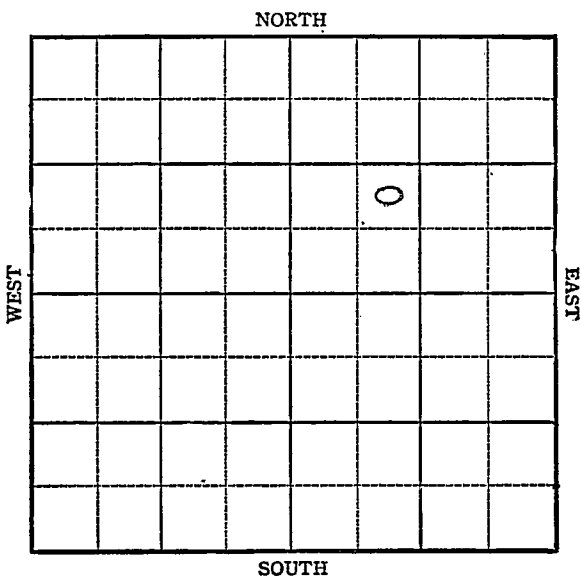

Sec. 17 Twp. 25 R. 5E

Well No. #31 Robinson Farm

Texas Company


Miscellaneous

           Ft. from N. Line

990 Ft. from S. Line

           Ft. from E. Line

990 Ft. from W. Line

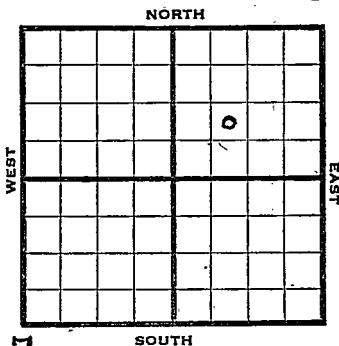

NE SW NE Elev. 1367

R E P O R T

1944

- 9/20 Location
- 9/28       "
- 10/4       "
- 10/11      "
- 10/18 Cable rig
- 11/1       12" @ 880  
          Drlg. 1645
- 11/8       10" @ 1666  
          KC- 2000  
          Drlg. 2075
- 11/16 Viola 2483  
          7" @ 2483  
          TD 2485 bail  
          15 gals oil per hr.
- 11/22 Viola 2483  
          7" @ 2483'  
          500 acid.  
          Pump 162 Pot.  
          TD 2485'  
          Grav. 38.0

COMPLETED

**KANSAS**

Pool Name Miscellaneous

Map No. 14 Sec. 17 Twp. 25 R. 5E

Well No. 31 Robinson

Texas Company

**FIRST REPORT**

Contractor

NE SW NE

**SECTION PLAT**

           Ft. from N. Line

990 Ft. from S. Line

           Ft. from E. Line

990 Ft. from W. Line

		o	

Butler

Location X

Rig up           

Drilling and Remarks:

**RECORD**

Cased            in.,            ft.

Sand           

Gas           

Oil           

Total Depth           

**PRODUCTION**

1st 24 hrs. Nat.           

1st 24 hrs. after shot           

Gas            Cu. Ft.

Dry Hole           

Abandoned           

Date

SEP 20 1944

19

S. I. LEWIS

Scout

Pool Name Miscellaneous

Map No. 14 Sec. 17 Twp. 25 R. 5E

Well No. 31 Robinson

Texas Company

**COMPLETED** Contractor

NE SW NE

SECTION PLAT

990 Ft. from N. Line

\_\_\_\_\_ Ft. from S. Line

\_\_\_\_\_ Ft. from E. Line

990 Ft. from W. Line

		6	

Butler

Location \_\_\_\_\_

Rig up \_\_\_\_\_

Drilling and Remarks:

*Vista 2483*

*2" @ 2483*

*5000 accl*

*Pump 162 P.D.*

*38° SW*

RECORD

Cased \_\_\_\_\_ in., \_\_\_\_\_ ft.

Sand \_\_\_\_\_

Gas \_\_\_\_\_

Oil \_\_\_\_\_

Total Depth 2485

PRODUCTION

1st 24 hrs. Nat. \_\_\_\_\_

1st 24 hrs. after shot \_\_\_\_\_

Gas \_\_\_\_\_ Cu. Ft.

Dry Hole \_\_\_\_\_

Abandoned \_\_\_\_\_

Date

NOV 22 1944

19

S. I. LEWIS

Scout