

KANSAS

Ness County

Sec. 34 Twp. 17 R. 25W

Well No. 2 Reed "E" Farm _____

Magnolia Company _____


Aldrich

1004 Ft. from N. Line

_____ Ft. from S. Line

_____ Ft. from E. Line

990 Ft. from W. Line

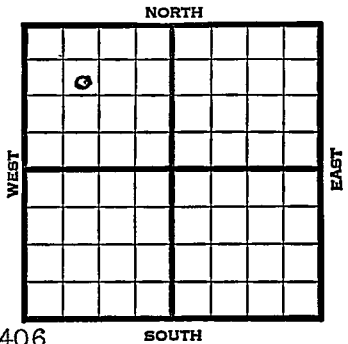

SE NW NW Elev. 2406 SOUTH

1945

REPORT

- 4/25 RUR
- 4/27 #
- 5/3 8" @ 250' WOC
- 5/10 Drlg. 3115
- 5/17 Lans 3763
- 5/24 Drlg. 4088
- 5/24 Miss 4336-4344
- 5/31 TD 4344
- 5/31 5" @ 4336' RUST
- 5/31 70 shots 4337-4344
- 6/8 2000 acid.
- 6/8 500 acid pump 24 oil plus 184 water in 19 hrs.
- 6/20 Mi s. 4336
- 6/20 5" @ 4336
- 6/20 70 shots 4337-4344
- 6/20 2500 acid.
- 6/20 TD 4344
- 6/20 Pump 25 oil plus 2 1/2 Wtr. Pot.
- 6/20 Grav. 37.5

COMPLETED

~~Kansas~~

Pool Name Aldrich

Map No. 77 Sec. 34 Twp. 17 R. 25W

Well No. 2 Reed "E"

Magnolia Company

FIRST REPORT

Contractor

SE NW NW


SECTION FLAT

1004 Ft. from N. Line

_____ Ft. from S. Line

_____ Ft. from E. Line

990 Ft. from W. Line

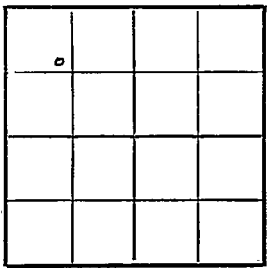

Ness County

Location _____

Rig up _____

Drilling and Remarks:
RUR

RECORD

Cased _____ in., _____ ft.

Sand _____

Gas _____

Oil _____

Total Depth _____

PRODUCTION

1st 24 hrs. Nat. _____

1st 24 hrs. after shot _____

Gas _____ Cu. Ft.

Dry Hole _____

Abandoned _____

Date

APR 25 1945 19

S. J. LEWIS

Scout

Kansas Pool Name Aldrich

Map No. _____ Sec. 34 Twp. 17 R. 25W

Well No. 2 Reed "E"

Magnolia Company

COMPLETED

Contractor

SE NW NW

E12406
SECTION PLAT

1004 Ft. from N. Line

_____ Ft. from S. Line

_____ Ft. from E. Line

990 Ft. from W. Line

6			

Ness County

Location _____

Rig up _____

Drilling and Remarks:

Miss 4326
5' @ 4326
70 shot to 4337-44
2500 acid
Pump 25 oil 1 1/2 W
P.O.T.
37-5-44

RECORD

Cased _____ in., _____ ft.

Sand _____

Gas _____

Oil _____

Total Depth 4344

PRODUCTION

1st 24 hrs. Nat. _____

1st 24 hrs. after shot _____

Gas _____ Cu. Ft.

Dry Hole _____

Abandoned _____

Date

JUN 20 1945 19

S. J. LEWIS Scout